

LAND CORNER RECORDATION CERTIFICATE
Filing Requirement of Act 74, Mich. P.A. 1970 as Amended

For corners in

Houghton (County)	Located In:	Corner Code #
1. Public Land Survey	T R	
	T R	
	T R	
2. Property Controlling in Section	S 11 T 55N R 33W	14
	S 11 T 55N R 33W	C-E-SE 1/64
	S T R	
3. Miscellaneous Property in Sec.	S T R	
	S T R	
4. Lot No. _____, Recorded Plat		
5. Private Claims		

Register of Deeds Stamp & File Number

1	A	B	C	D	E	F	G	H	I	J	K	L	M
2	6	5	4	3	2	1							
3													
4	7	8	9	10	11	12							
5													
6	18	17	16	15	14	13							
7													
8	19	20	21	22	23	24							
9													
10	30	29	28	27	26	25							
11													
12	31	32	33	34	35	36							
13													

I, Stephan J. Szyszkoski, in a field survey on 1/64 07/27/2011 do hereby state
that under requirements of P.A. 74, Michigan P.A. of 1970, the corner points mentioned in lines 1 and 2
above were in conformance with regulations and rules therefore as required in the current manual of survey
instructions of the United States Department of the Interior, Bureau of Land Management or by a decree of
a Court of Law and /or that the corner points mentioned in lines 3, 4 and 5 above were in conformance with
the rules of the Michigan Board of Land Surveyors or by a Decree of a Court of Law; established,
re-established, monumented, recovered, found as expressed below:

NOTE: Not more than 2 corners, all in the same town and range, may be recorded
on this certificate.

A. Description of original monument and accessories and/or subsequent restoration:

(14-Sec. 11) South 1/16 corner between Sections 11 and 12. 1989 - Established by R.W.Crampton PS
#24591 midway and on a straight line between Quarter corner K4 1318.80' north and Section corner K5
1318.80' south. Position not monumented. Mr. Crampton placed a 1/2" capped iron pipe 46.09' east
for a reference.

(C-E-SE 1/64 corner, Sec. 11) The NE corner of the NW1/4 of the SE1/4 of the SE1/4 of Section 11.
Found no record of prior monumentation.

B. Description of corner evidence found and/or method applied in restoring or reestablishing corner:

(14-Sec. 11) Found no monumentation at the corner position. Reestablished the corner midway and on a
straight line between Quarter corner K4 1318.68' north and Section corner K5 1318.68' south. Found a
1/2" capped iron pipe #24591 45.7' east. The position for the corner falls about 3' west of the west
edge of the gravel surface of Golf Course Road, but still within the travelled way.

(C-E-SE 1/64) Found no monumentation at the corner position. Established the corner midway and on a
straight line between 1/16 corners #13 and #14 662.09' west and east.

C. Description of monument for corner and accessories established to perpetuate locating the position of the corner:


(14) Set 1"IDx32" I.pipe with 4" alum. MDNR cap
buried 7" below gravel surface.
Set measuring nail with MDNR tag in the side of:
10" R.Pine N87E 44.55' mrkd "1/16S BT"
6" W.Pine S21W 28.3' do
8" Maple S80W 20.45' do
5" Oak N55W 19.4' do
Bearings are magnetic.

1/64 - Set 1"IDx32" I.pipe w/4" alum. MDNR cap.
Set measuring nail with MDNR tag in the side of:
6" W.Birch N14W 15.7' mrkd "1/64S BT"
6" Sugar S61E 15.95' do
6" Sugar S23E 14.0' do
11" Sugar S55W 8.15' do
Set sq'd cedar post adjacent.
Bearings are magnetic.

Signed by Stephan J. Szyszkoski
Surveyor's Michigan License No. 33986

Date 11/15/2011

For the Michigan Department of Natural Resources, Forest Management Division

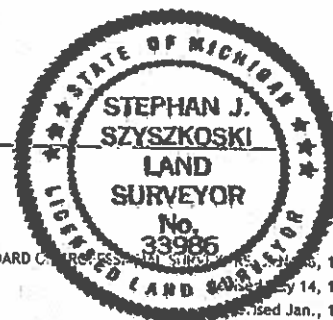

16769

16768