

APPROVED LAND CORNER
P.A. 345 OF 1990
Houghton County

SURVEY &
REMONUMENTATION

LAND CORNER RECORDATION CERTIFICATE
Filing Requirement of Act 74, Mich. P.A. 1970

JAN 09 1998

SEP 23 1997
Robert W. Crampton
For corners in
HOUGHTON
(County)

Located In:

Corner Code #

SECTION

1. Public Land Survey T 55N R 34W
T _____ R _____
T _____ R _____
T _____ R _____
2. Property Controlling S _____ T _____ R _____
in Section S _____ T _____ R _____
3. Miscellaneous S _____ T _____ R _____
Property in Section S _____ T _____ R _____

K-11, K-12

NANCY FENILI 09/23/97

HOUGHTON COUNTY

LC

3/ 424 PAU Fee:

14:32

9.00

Page 1 of 1

Register of Deeds Stamp & File Number

4. Lot No. _____, Recorded Plat _____
5. Private Claims _____

I, R.W. CRAMPTON, in a field survey on JUNE, 1997,
do hereby certify that under requirements of P.A. 74, Michigan P.A. of 1970, the corner points mentioned
in lines 1 and 2 above were in conformance with regulations and rules therefore as required in the current
manual of survey instructions of the United States Department of the Interior, Bureau of Land
Management or by a decree of a Court of Law and/or that the corner points mentioned in lines 3, 4 and
5 above were in conformance with the rules of the Michigan Board of Professional Surveyors or by a
Decree of a Court of Law; established, re-established, monumented, re-monumented, recovered, found
as expressed below:

NOTE: Not more than 4 corners, all in the same town and range, may be recorded
on this certificate.

A. Description of original monument and accessories and/or subsequent restoration:

K-11 SET POST CORNER OF SECTIONS 35 & 36, HEMLOCK 7 N38E 18, HEMLOCK 7 N14W 17.

K-12 SET QUARTER SECTION POST, W. BIRCH, 5 S76W 5, W. BIRCH, 4 N73E 8.

B. Description of corner evidence found and/or method applied in restoring or reestablishing corner:


K-11 FOUND 1/2" IRON PIN, SET 1/2" IRON PIPE WITH 2 1/4" BRASS CAP OVER PIN. PREVIOUSLY RECORDED BY JOHN
SMALLWOOD, LIBER 1, PAGE 581.

K-12 FOUND 1/2" IRON PIPE FROM J. SMALLWOOD WITNESSES. SET 1" IRON PIPE WITH 2 1/4" BRASS CAP OVER
1/2" IRON PIPE. PREVIOUSLY RECORDED BY JOHN SMALLWOOD, LIBER 1, PAGE 583.

C. Description of monument for corner and accessories established to perpetuate locating the position of the corner:

K-11 1/2" IRON PIPE WITH BRASS CAP, WITNESSED WITH SURVEY TAG NAILED TO:
22" MAPLE TREE N06°E 21.04', 24" MAPLE TREE N87°E 29.88',
N 83.18' TO THE SE CORNER OF GARAGE, N47°W 85.68' TO THE SE CORNER OF HOUSE.

K-12 1" IRON PIPE WITH BRASS CAP, WITNESSED WITH SURVEY TAG NAILED TO:
27" MAPLE TREE N17°E 24.80', 3" APPLE TREE S80°W 33.80',
2" MAPLE TREE S59°W 39.05', N58°E 53.32' TO THE NE CORNER OF THE NW STEP POST.

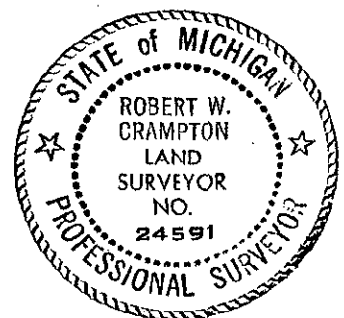

Signed by Robert W. Crampton

Date AUG. 26, 1997

Surveyor's Michigan License No. 24591