

**LAND CORNER RECORDATION CERTIFICATE**  
**Filing Requirement of Act 74, Mich. P.A. 1970**

For corners in

<u>Huron</u> (County)	Located In:	Corner Code //
1. Public Land Survey	T 15N R 14E	E-3
	T 15N R 14E	F-3
	T 15N R 14E	G-3
	T R	
2. Property Controlling in Section	S T R	
	S T R	
3. Miscellaneous Property in Sec.	S T R	
	S T R	

**Register of Deeds Stamp & File Number**

4. Lot No. \_\_\_\_\_, Recorded Plat \_\_\_\_\_

5. Private Claims \_\_\_\_\_

I, Donald L. Bissell, in a field survey on January, 19 89, do hereby certify that under requirements of P.A. 74, Michigan P.A. of 1970, the corner points mentioned in lines 1 and 2 above were in conformance with regulations and rules therefore as required in the current manual of survey instructions of the United States Department of the Interior, Bureau of Land Management or by a decree of a Court of Law and/or that the corner points mentioned in lines 3, 4 and 5 above were in conformance with the rules of the Michigan Board of Land Surveyors or by a Decree of a Court of Law; established, re-established, monumented, re-monumented, recovered, found as expressed below:

**NOTE: Not more than 4 corners, all in the same town and range, may be recorded on this certificate.**

A. Description of original monument and accessories and/or subsequent restoration:

	A	B	C	D	E	F	G	H	I	J	K	L	M
2	6		5		4		3		2		1		
3					9	8	7						
4	7		8		9	10	11		12				
5													
6	18		17		16		15		14		13		
7													
8	19		20		21		22		23		24		
9													
10	30		29		28		27		26		25		
11													
12	31		32		33		34		35		36		
13													

B. Description of corner evidence found and/or method applied in restoring or reestablishing corner:

**B-3**

SW Cor. Sec. 4, T15N, R14E  
 Fd. 3/4" iron in mon. box  
 Inters. MacDonald & Purdy Roads

**F-3**

S 1/4 Cor. Sec. 4, T15N, R14E  
 Fd. 1/2" bar in mon. box,  
 centerline of Purdy road.

**G-3**

SE Cor. Sec. 4, T15N, R14E, Fd. 5/8"  
 iron bar in mon. box at intersection  
 of Purdy and Polk Roads.

C. Description of monument for corner and accessories established to perpetuate locating the position of the corner:

**E-3**

N45°E - 55.58' - Power Pole  
 S34°E - 53.00' - Power Pole  
 S33°W - 44.3' W end 18" C.M.P.

**F-3**


N69°E - 92.27' First wood fence  
 post east  
 S62°E - 108.56' - Power pole  
 S06°W - 42.88' - Cor. fence post  
 West - 18' - centerline field  
 drive South

**G-3**

N21°E - 100.52' - Maple Clump West stalk, 6"  
 N30°W - 53.00' - Anchor Pole  
 S45°W - 52.88' - Power Pole

Signed by Donald L. Bissell Date \_\_\_\_\_

Surveyor's Michigan License No. 18655

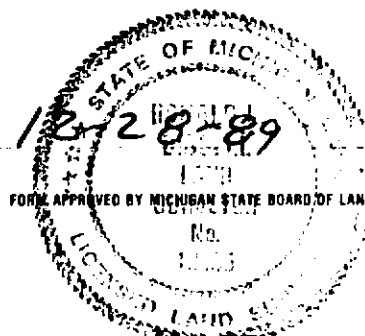

FORM APPROVED BY MICHIGAN STATE BOARD OF LAND SURVEYORS, JAN. 28, 1971  
 REVISED MAY 14, 1975  
 REVISED JAN. 1, 1983