

SURVEY &  
REMONUMENTATION

JAN 22 1998

REMONUMENTATION

LAND CORNER RECORDATION CERTIFICATE  
Filing Requirement of Act 74, Mich. P.A. 1970

Re-Monument 1, Page 75

SECTION

For corners in

Huron

(County)

Located In:

Corner Code #

STATE OF MICHIGAN  
HURON COUNTY  
RECORDED

6 NOV 97 10:26 A.M.

FRANCES L. HOLDWICK  
REGISTER OF DEEDS

Register of Deeds Stamp & File Number

1. Public Land Survey Sherman T15N R16E A-13  
T R B-13  
T R  
T R  
2. Property Controlling S T R  
in Section S T R  
3. Miscellaneous S T R  
Property in Sec. S T R

4. Lot No. , Recorded Plat  
5. Private Claims

I, Charles S. Getz, in a field survey on Nov. 3, 1997 do hereby state that under requirements of P.A. 74, Michigan P.A. of 1970, the corner points mentioned in lines 1 and 2 above were in conformance with regulations and rules therefore as required in the current manual of survey instructions of the United States Department of the Interior, Bureau of Land Management or by a decree of a Court of Law and /or that the corner points mentioned in lines 3, 4 and 5 above were in conformance with the rules of the Michigan Board of Land Surveyors or by a Decree of a Court of Law; established, re-established, monumented, recovered, found as expressed below:

NOTE: Not more than 2 corners, all in the same town and range, may be recorded on this certificate.

	A	B	C	D	E	F	G	H	I	J	K	L	M
1													
2	6		5		4		3		2		1		
3													
4	7		8		9		10		11		12		
5													
6	18		17		16		15		14		13		
7													
8	19		20		21		22		23		24		
9													
10	30		29		28		27		26		25		
11													
12	31		32		33		34		35		36		
13													

A. Description of original monument and accessories and/or subsequent restoration:

A-13 1834 G.L.O., H. Parke D.S.  
Post  
Beech 16", S70°E, 11½ Links  
do. 16", N31°W, 4 Links

County Surveyor Records - NONE, Co. Rd. Comm. Records - NONE  
Recorded Surveys - NONE Unrecorded Surveys - NONE  
L.C.R.C. 1996 Remonumentation - 1" Pipe

B-13 1834 G.L.O., H. Parke D.S.  
Set quarter section post  
Sugar 18", N48°W, 35 Links  
Beech 6", N35°E, 25 Links

County Surveyor Records - NONE Co. Rd. Comm. Records - NONE  
Recorded Surveys - NONE Unrecorded Surveys - NONE  
L.C.R.C. - NONE

B. Description of corner evidence found and/or method applied in restoring or reestablishing corner:

A-13  
SW Cor, Section 31, T15N-R16E  
Found 1" Pipe  
Accepted as the best available evidence  
of original corner position  
(Intersection of Huron Line & Edwards Roads)

B-13  
S 1/4 Cor, Section 31, T15N-R16E  
Found no evidence of original corner position.  
Re-established corner position by proportion-  
ate measure from G.L.O. Notes, between C-13  
and A-13 as best evidence of original corner  
position for B-13.

C. Description of monument for corner and accessories established to perpetuate locating the position of the corner:

A-13  
SW Cor, Section 31, T15N-R16E  
Found 1" Pipe  
East 31.15' to Nail in N. Side of Tele Pole  
S85°E 38.70' to Nail in S. Side of Fence Post  
S75°E 40.65' to Nail in S. Side of Fence Post  
N45°W 38.70' to Road Sign  
S45°W 41.60' to Stop Sign  
West 2631.80' to S 1/4 Cor, Sec 36, T15N-R15E  
East 2631.04' to S 1/4 Cor, Sec 31, T15N-R16E


B-13  
S 1/4 Cor, Section 31, T15N-R16E  
Set 1/2" Re-Rod (Capped)  
N70°W 4.74' to Nail in 12" Apple Tree  
West 12.10' to Nail in 12" Birch  
S50°W 12.20' to Nail in 12" Birch  
East 20.15' to Nail in 18" Birch  
West 2631.04' to SW Cor, Sec 31, T15N-R16E  
East 2631.04' to SE Cor, Sec 31, T15N-R16E

Signed by Charles S. Getz  
Surveyor's Michigan License No. 25843

Date November 4, 1997

PEER GROUP APPROVED AT  
MEETING November 5, 1997.

RLB

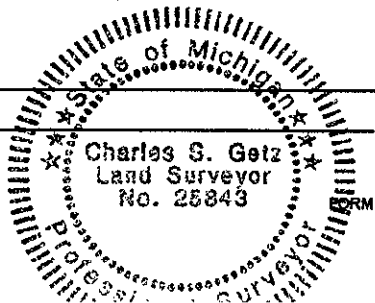

FORM APPROVED BY MICHIGAN STATE BOARD OF PROFESSIONAL SURVEYORS, JAN. 28, 1971  
REVISED MAY 14, 1975  
REVISED JAN., 1983  
REVISED OCT., 1995