

JAN 19 2001

2000 REMONUMENTATION

Re-Mon Liber 2, Page 78

SECTION

LAND CORNER RECORDATION CERTIFICATE
Filing Requirement of Act 74, Mich. P.A. 1970

For corners in

Huron (County)	Located in:	Corner Code #
1. Public Land Survey	Sherman T15N R16E	A-5
	T R	
	T R	
	T R	
2. Property Controlling in Section	S T R	
	S T R	
3. Miscellaneous Property in Sec.	S T R	
	S T R	

STATE OF MICHIGAN
HURON COUNTY
RECORDED

20 SEP 2000 2:06 PM

FRANCES L. HOLWICK
REGISTER OF DEEDS

Register of Deeds Stamp & File Number

4. Lot No. _____, Recorded Plat _____
5. Private Claims _____

I, Charles S. Getz, in a field survey on May 10, 2000, do hereby state that under requirements of P.A. 74, Michigan P.A. of 1970, the corner points mentioned in lines 1 and 2 above were in conformance with regulations and rules therefore as required in the current manual of survey instructions of the United States Department of the Interior, Bureau of Land Management or by a decree of a Court of Law and/or that the corner points mentioned in lines 3, 4 and 5 above were in conformance with the rules of the Michigan Board of Land Surveyors or by a Decree of a Court of Law; established, re-established, monumented, recovered, found as expressed below:

NOTE: Not more than 2 corners, all in the same town and range, may be recorded on this certificate.

A	B	C	D	E	F	G	H	I	J	K	L	M
2	6	5		4	3		2		1			
3												
4	7	8		9	10		11		12			
5												
6	10	17		16	15		14		13			
7												
8	19	20		21	22		23		24			
9												
10	30	29		28	27		26		25			
11												
12	31	32		33	34		35		36			
13												

A. Description of original monument and accessories and/or subsequent restoration:

A-5 1834 G.L.O., H. Parke D.S. County Road Commission Records - Iron Pin; Ford Axle
Set Post
Hemlock 12", S10°W, 44 1/2 Links Recorded Surveys - Kay, 10-15-76, Liber 3, Page 80, 1" Axle Shaft
Sugar 9", N60°W, 15 Links Unrecorded Surveys - Case, 11-22-83, 3/4" Re-Rod in Mon. Box.

L.C.R.C. - NONE


County Surveyor Records -
NONE

B. Description of corner evidence found and/or method applied in restoring or reestablishing corner:

A-5
SW Cor, Section 7, T15N-R16E
Found 3/4" Bar in Monument Box, on Centerline of paved road
Accepted as the best available evidence
of the original corner position
(Intersection of Priemer Road & Edwards Road)

C. Description of monument for corner and accessories established to perpetuate locating the position of the corner:

A-5
SW Cor, Section 7, T15N-R16E
Found 3/4" Bar in Monument Box, on Centerline of paved road
S45°E 41.2' to Nail in Power Pole
S40°E 37.2' to Stop Sign
N45°W 40.45' to Stop Sign
N55°W 61.4' to Northwest corner of 5' C.M.P.
S55°E 50.6' to Southeast corner of 5' C.M.P.
North 2637.31' to W 1/4 Cor, Sec 7, T15N-R16E
South 2629.21' to W 1/4 Cor, Sec 18, T15N-R16E

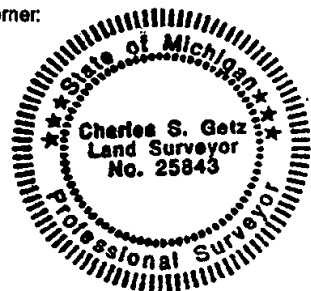

Signed by Charles S. Getz

Date June 3, 2000

Surveyor's Michigan License No. 25843

PEER GROUP APPROVED AT MEETING
HELD September 18, 2000. RLB