

*Common to M13 - Fair Haven Twp. - T16N-R9E
*Common to M01 - Sebewaing Twp. - T15N-R9E
*Common to A01 - Brookfield Twp. - T15N-R10E

Re-Mon - Liber 1 Page 130

REMONUMENTATION

LAND CORNER RECORDATION CERTIFICATE
Filing Requirement of Act 74, Mich. P.A. 1970

For Corners in

Huron
(County)

Located in:

Corner Code #

1. Public Land survey: Winsor

T 16 N R 10 E

A-13 ✓

T 15 N R 10 E

A-1

T 16 N R 9 E

M-13

T 15 N R 9 E

M-1

2. Property Controlling
in Section

S T R
S T R

3. Miscellaneous

S T R

STATE OF MICHIGAN
HURON COUNTY
RECORDED

9 DEC 97 11:13 A.M.

FRANCES L. HOLIDICK
REGISTER OF DEEDS

Register of Deeds Stamp & File Number

4. Lot No. , Recorded Plat

5. Private Claims

I, James T. Meek, in a field survey on October 30, 1997,
do hereby certify that under requirements of P.A. 74, Michigan P.A. of 1970, the corner points mentioned
in lines 1 and 2 above were in conformance with regulations and rules thereof as required in the
current manual of survey instructions of the United States Department of the Interior, Bureau of Land
Management or by a decree of a Court of Law and/or that the corner points mentioned in lines 3, 4 and 5
above were in conformance with the rules of the Michigan Board of Land Surveyors or by a Decree of a
Court of Law; established, re-established, monumented, re-monumented, recovered, found as
expressed below:

NOTE: Not more than 4 corners, all in the same town and range, may be recorded
on this certificate.

A. Description of original monument and accessories and/or subsequent restoration:
Original survey, South Bdy. T16NR10E, 1835, Harvey Parke D.S.

A-13 Corner of Townships 15 and 16 North, Ranges 9 and 10 East
Post
Lynn 20", N82°E, 29 links
B. Oak 20", S81°W, 41 links

County Surveyor's Record: ¾" iron
Recorded Surveys: L4, P552; L1, P477
LCRC: none

SURVEY &
REMONUMENTATION

JAN 22 1998

SECTION

B. Description of corner evidence found and/or method applied in restoring or reestablishing corner:

A-13 Corner of Townships 15 and 16 North, Ranges 9 and 10 East

Found 1" iron in mon box
At the intersection of Kilmanagh Rd. and Bay Port Rd.

Accepted as the best available evidence of the original corner position.

C. Description of monument for corner and accessories established to perpetuate locating the position of the corner:

A-13 Corner of Townships 15 and 16 North, Ranges 9 and 10 East

1" iron in mon box

From which:


Tag in PP bears N48°E, 40.9'
Road sign post bears S22°E, 40.0'
Tag in PP bears S50°W, 41.7'
Road sign post bears N35°W, 35.4'

Signed by

Date

Surveyor's Michigan License No. 39089

APPROVED AT PEER BOARD MEETING Nov 25, 1997 RLB

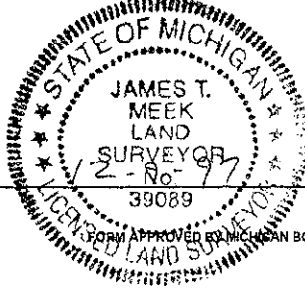

REVISOR: JAMES T. MEEK
REVISOR: JAMES T. MEEK
REVISOR: JAMES T. MEEK