

JAN 19 2001

SECTION

Re Mon Liber 2, Page 118

2000 REMONUMENTATION  
LAND CORNER RECORDATION CERTIFICATE  
Filing Requirement of Act 74, Mich. P.A. 1970

For Corners in VERONA Township

Huron  
(County)

Located In:

Corner Code #

1. Public Land Survey

T 16N R 13E A - 5

T \_\_\_\_\_ R \_\_\_\_\_

T \_\_\_\_\_ R \_\_\_\_\_

T \_\_\_\_\_ R \_\_\_\_\_

T \_\_\_\_\_ R \_\_\_\_\_

2. Property Controlling S  
in Section S

T \_\_\_\_\_ R \_\_\_\_\_

3. Miscellaneous S  
Property in Sec. S

T \_\_\_\_\_ R \_\_\_\_\_

T \_\_\_\_\_ R \_\_\_\_\_

STATE OF MICHIGAN  
HURON COUNTY  
RECORDED

8 DEC 2000 10:00 AM

FRANCES L. HOLDWICK  
REGISTER OF DEEDS


Register of Deeds Stamp & File Number

4. Lot No. \_\_\_\_\_, Recorded Plat \_\_\_\_\_


5. Private Claims \_\_\_\_\_

I, Russell L. Brown, in a field survey on July 14, 2000 do hereby state that under requirements of P.A. 74, Michigan P.A. of 1970, the corner points mentioned in lines 1 and 2 above were in conformance with regulations and rules therefore as required in the current manual of survey instructions of the United States Department of the Interior, Bureau of Land Management or by a decree of a Court of Law and/or that the corner points mentioned in lines 3, 4, and 5 above were in conformance with the rules of the Michigan Board of Land Surveyors or by a Decree of a Court of Law; established, re-established, monumented, recovered, found as expressed below:

NOTE: Not more than 2 corners, all in the same town and range, may be recorded on this certificate.

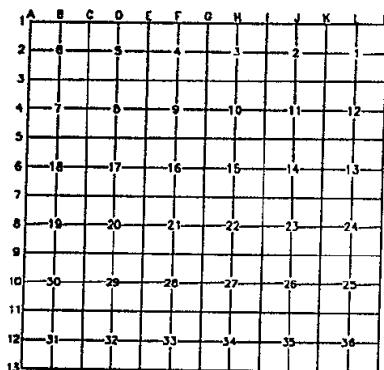

A. Description of original monument and accessories and/or subsequent restoration:  
1834, GLO, H. Parke D.S. Set post corner Sections 12 and 13, East side T16N-R12E  
Beech 12 N48W 7 1/2; DO 14 S12 1/2W 35  
COUNTY SURVEYOR RECORD: None  
COUNTY ROAD COMMISSION RECORD: Monument Box, no witnesses  
L.C.R.C.: None  
RECORDED SURVEYS: Continued next page  
UNRECORDED SURVEYS: Continued next page  
RECORDED PLATS: Continued next page  
MDOT PLAN: Continued next page

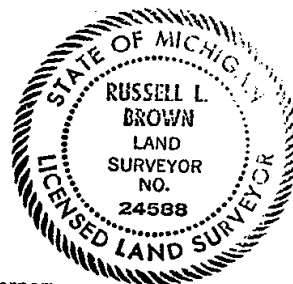

B. Description of corner evidence found and/or method applied in restoring or reestablishing corner:

No evidence of original corner or accessories found.

Found axle shaft with gear in concrete, Set Monument Box over axle Shaft.

Set Monument Box over found Axle Shaft with gear in concrete, from monuments located in the recorded plat of Nugents North Heights Subdivision, as recorded in Liber 6 of Plats on Page 14 of Huron County Records as best evidence of original corner position.

C. Description of monument for corner and accessories established to perpetuate locating the position of the corner:

A - 5, S.W. Cor. Sec. 7, and N.W. Cor. Sec. 18, T16N-R13E  
Set Monument Box over found Axle Shaft with Gear in concrete

WITNESSES:

N40°E 77.12' to Nail & Washer in N.W. Side of Power Pole

S60°E 56.90' to R.R.S. in West Side of Power Pole

S40°W 63.39' to 1/2" Dia. Re-Rod Set

N50°W 68.61' to P.K. Nail in N.E. Side of P.P.

S85°W 3.12' to 1/2" Re-Rod in Monument Box

South 2622.91' to A-6, W. 1/4 Cor. Sec. 18, T16N-R13E

North 2631.12' to A-4, W. 1/4 Cor. Sec. 7, T16N-R13E

NOTE:

This corner is common with  
M - 5, T16N-R12E

Signed by Russell L. Brown  
Surveyor's Michigan License No. 24588

Date Nov. 2, 2000

Peer group approved at meeting held November 2, 2000. RUB

JAN 19 2001

SECTION

*Re-Mon Liber 2, Page 118 A*

2000 REMONUMENTATION  
LAND CORNER RECORDATION CERTIFICATE  
Filing Requirement of Act 74, Mich. P.A. 1970

For corners in VERONA Township,  
Huron County, T16N-R13E  
A-5 Continued Sheet 2 of 2 Sheets

RECORDED SURVEYS:

7-28-75, Case Surveying, Stewart G. Case P.S. 15399, Liber 2 survey, Page 416 of Huron County Records.  
N.E. Cor. Sec. 13, T16N-R12E, Colfax Township  
Monument Box in place 3.0 feet West of centerline of Highway M-53 and in line with centerline of Highway M-142 to the West covered with asphalt.  
No witnesses given

7-7-78, Case Surveying, Stewart G. Case P.S. 15399, Liber 3 survey, page 432 of Huron County Records.  
S.E. Cor. Sec. 12, T16N-R12E  
P.K. Nail in place at intersection of centerlines of Highway M-142 and Highway M-53.  
No witnesses given

5-21-79, Case Surveying, Stewart G. Case P.S. 15399, Liber 4 survey, page 123 of Huron County Records.  
S.E. Cor. Sec. 12, T16N-R12E  
Same object as Liber 3 survey, page 432 of Huron County Records.  
No witnesses given

UNRECORDED SURVEYS:

4-27-93, Huron Surveying, Inc., Russell L. Brown P.S. 24588  
S.E. Cor. Sec. 12, T16N-R12E  
Found Monument Box  
No witnesses given

RECORDED PLATS:

1958, Galen W. Case P.S. 7431, Liber 6 of Plats on Page 14 of Huron County Records.  
Nugent's North Heights Subdivision  
N.W. Cor. Frac. Sec. 18, T16N-R13E  
No object stated; No witnesses given

MDOT PLAN:

1932, MDOT PLAN Federal Aid Project No. E181 Sec. B  
Exact Corner Sections 12 and 13, Colfax Township and 7 and 8 Verona Township  
Monument Box in Pavement; No witnesses

1965, MDOT PLAN Michigan Project F181(4) State Project F32032C C2  
Section Corner common to 13-12-18 and 7  
Cedar Post

S47°W 45.5' Spike in Anchor Post;  
N30°E 44.4' No object stated;

N42°15'W 45.85' Spike in Anchor Post  
S42°30'E 44.0' No object stated

1984, MDOT PLAN FR32032-12379

N.E. Cor. Sec. 13, T16N-R12E

No object stated

N40°E 78.90' Nail & Tag P.P.;

S35°W 93.25' Nail & Tag Guy Pole

S45°E 48.16' Nail & Tag Guy Pole

1995, MDOT PLAN by Rowe Engineering, Inc. Michigan Project 9632(002)

N.E. Cor. Sec. 13, T16N-R12E

No object stated

No witnesses given

