

JAN 19 2001

Re-Man. Liber 2, Page 58
2000 REMONUMENTATION

SECTION

LAND CORNER RECORDATION CERTIFICATE
Filing Requirement of Act 74, Mich. P.A. 1970

For corners in

Huron	Located in:	Corner Code #
(County)		
1. Public Land Survey Sand Beach	T16N R15E	A-4
	T R	
	T R	
	T R	
2. Property Controlling in Section	S T R	
	S T R	
3. Miscellaneous Property in Sec.	S T R	
	S T R	

STATE OF MICHIGAN
HURON COUNTY
RECORDED

20 SEP 2000 2:02 PM

FRANCES L. HOLDWICK
REGISTER OF DEEDS

Register of Deeds Stamp & File Number

4. Lot No. _____, Recorded Plat _____
5. Private Claims _____

I, Charles S. Getz, in a field survey on May 17, 2000 do hereby state that under requirements of P.A. 74, Michigan P.A. of 1970, the corner points mentioned in lines 1 and 2 above were in conformance with regulations and rules therefore as required in the current manual of survey instructions of the United States Department of the Interior, Bureau of Land Management or by a decree of a Court of Law and/or that the corner points mentioned in lines 3, 4 and 5 above were in conformance with the rules of the Michigan Board of Land Surveyors or by a Decree of a Court of Law; established, re-established, monumented, recovered, found as expressed below:

NOTE: Not more than 2 corners, all in the same town and range, may be recorded on this certificate.


	A	B	C	D	E	F	G	H	I	J	K	L
1												
2	6		5		4		3		2			
3												
4	7		8		9		10		11			
5												
6	18		17		16		15		14			
7												
8	19		20		21		22		23			
9												
10	30		29		28		27		26			
11												
12	31		32		33		34		35			
13												

A. Description of original monument and accessories and/or subsequent restoration:
A-4 1834 G.L.O., H. Parke D.S. County Road Commission Records - Iron Pin in Post
Set quarter section post
Hemlock 14", N44°W, 26 1/2 Links Recorded Surveys - NONE
B. Ash 5", S7°W, 18 Links Unrecorded Surveys - NONE
L.C.R.C. - NONE

County Surveyor Records -
July 5th, 1884, Duncan McFadden,
Survey shows Corner

B. Description of corner evidence found and/or method applied in restoring or reestablishing corner:
A-4
W 1/4 Cor, Section 7, T16N-R15E
Found no evidence of original corner position
Re-established corner position by proportionate measure from G.L.O. Notes,
between A-3 and A-5 as best evidence of original corner position for A-4.
(On Finkel Road)

C. Description of monument for corner and accessories established to perpetuate locating the position of the corner:
A-4
W 1/4 Cor, Section 7, T16N-R15E
Set 1/2" Re-Rod (Capped)
S85°W 24.00' to North End of 4.0' C.M.P.
S30°W 52.00' to South End of 4.0' C.M.P.
North 2612.87' to NW Cor, Sec 7, T16N-R15E
South 2612.87' to SW Cor, Sec 7, T16N-R15E

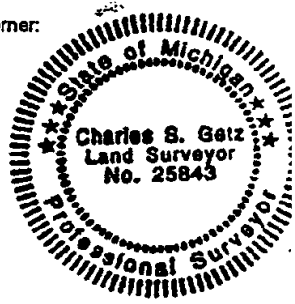

Signed by Charles S. Getz
Surveyor's Michigan License No. 25843

Date June 10, 2000

PEER GROUP APPROVED AT MEETING
HELD September 18, 2000. RLB.