

JAN 19 2001

SECTION

2000 REMONUMENTATION

Re. Mon. Liber 3, Page 67

LAND CORNER RECORDATION CERTIFICATE
Filing Requirement of Act 74, Mich. P.A. 1970

For corners in

Huron

(County)

Located in:

Corner Code #

1. Public Land Survey Sand Beach T16NR16E A-5
 T R
 T R
2. Property Controlling S T R
 in Section S T R
 3. Miscellaneous S T R
 Property in Sec. S T R

STATE OF MICHIGAN
HURON COUNTY
RECORDED

20 SEP 2000 2:03 PM

FRANCES L. HOLDWICK
REGISTER OF DEEDS

Register of Deeds Stamp & File Number

4. Lot No. _____, Recorded Plat _____
 5. Private Claims _____

I, Charles S. Getz, in a field survey on July 18, 2000, do hereby state that under requirements of P.A. 74, Michigan P.A. of 1970, the corner points mentioned in lines 1 and 2 above were in conformance with regulations and rules therefore as required in the current manual of survey instructions of the United States Department of the Interior, Bureau of Land Management or by a decree of a Court of Law and/or that the corner points mentioned in lines 3, 4 and 5 above were in conformance with the rules of the Michigan Board of Land Surveyors or by a Decree of a Court of Law; established, re-established, monumented, recovered, found as expressed below.

NOTE: Not more than 2 corners, all in the same town and range, may be recorded on this certificate.

	A	B	C	D	E	F	G	H	I	J	K	L
1												
2	6	5	4	3	2	1						
3												
4	7	8	9	10	11	12						
5												
6	18	17	16	15	14	13						
7												
8	19	20	21	22	23	24						
9												
10	30	29	28	27	26	25						
11												
12	31	32	33	34	35	36						
13												

A. Description of original monument and accessories and/or subsequent restoration:

A-5 1834 G.L.O., H. Parke D.S. County Road Commission Records - NONE

Set Post

W. Ash 10", N39°W, 19 Links
Pine 18", S29°W, 53 Links

Recorded Surveys - Case, 2-22-72, Liber 1, Page 168, 1-1/2" Pipe
 Case, 5-13-77, Liber 3, Page 287, 1-1/2" Pipe
 Brown, 5-28-78, Liber 3, Page 397, 1-1/2" Pipe
 Brown, 5-28-78, Liber 3, Page 398, 1-1/2" Pipe
 Brown, 5-28-78, Liber 3, Page 404, 1-1/2" Pipe
 Burgin, 7-16-97, Liber 5, Page 193, Ref L 3 Pg 287
 Burgin, 11-4-97, Liber 5, Page 203, Ref L 3 Pg 287

L.C.R.C. - NONE

County Surveyor Records - NONE

Unrecorded Surveys -

Brown, 1-12-79, 1-1/2" Pipe

B. Description of corner evidence found and/or method applied in restoring or reestablishing corner:

A-5

SW Cor, Section 7, T16N-R16E

Found 1-1/2" Pipe in the Centerline of a drainage ditch

Accepted as the best available evidence

of the original corner position

C. Description of monument for corner and accessories established to perpetuate locating the position of the corner:

A-5

SW Cor, Section 7, T16N-R16E


Found 1-1/2" Pipe in the Centerline of a drainage ditch

N85°E 27.94' to Nail in 15" Ash

S45°W 6.3' to Nail in 18" Ash

S50°W 13.2' to Nail in 18" Ash

South 2628.30' to W 1/4 Cor, Sec 18, T16N-R16E

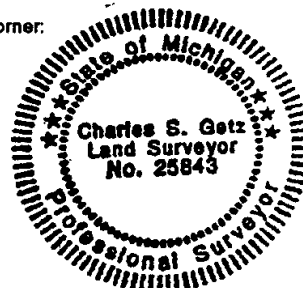

Signed by

Charles S. Getz

Date

July 23, 2000

Surveyor's Michigan License No.

25843

PEER GROUP APPROVED AT MEETING

HELD September 18, 2000. RLB

FORM APPROVED BY MICHIGAN STATE BOARD OF PROFESSIONAL SURVEYORS, JAN. 26, 1971
 REVISED MAY 14, 1975
 REVISED JAN., 1983
 REVISED OCT., 1995