

JAN 19 2001

2000 REMONUMENTATION

Re Mon Rehev 2, Page 68

SECTION

LAND CORNER RECORDATION CERTIFICATE
Filing Requirement of Act 74, Mich. P.A. 1970

For corners in

<u>Huron</u> (County)	Located In:	Corner Code #
1. Public Land Survey Sand Beach	T16N R16E	A-6
	T R	
	T R	
	T R	
2. Property Controlling In Section	S T R	
	S T R	
3. Miscellaneous Property in Sec.	S T R	
	S T R	

STATE OF MICHIGAN
HURON COUNTY
RECORDED

20 SEP 2000 2:04 PM

FRANCES L. HOLDWICK
REGISTER OF DEEDS

Register of Deeds Stamp & File Number

4. Lot No. _____, Recorded Plat _____
5. Private Claims _____

I, Charles S. Getz, in a field survey on July 18, 2000 do hereby state that under requirements of P.A. 74, Michigan P.A. of 1970, the corner points mentioned in lines 1 and 2 above were in conformance with regulations and rules therefore as required in the current manual of survey instructions of the United States Department of the Interior, Bureau of Land Management or by a decree of a Court of Law and/or that the corner points mentioned in lines 3, 4 and 5 above were in conformance with the rules of the Michigan Board of Land Surveyors or by a Decree of a Court of Law; established, re-established, monumented, recovered, found as expressed below:

NOTE: Not more than 2 corners, all in the same town and range, may be recorded on this certificate.

A	B	C	D	E	F	G	H	I	J	K	L
2	6	5	4	3	2	1					
3											
4	7	8	9	10	11	12					
5											
6	18	17	16	15	14	13					
7											
8	19	20	21	22	23	24					
9											
10	30	29	28	27	26	25					
11											
12	31	32	33	34	35	36					
13											

A. Description of original monument and accessories and/or subsequent restoration:

A-6 1834 G.L.O., H. Parke D.S.
Set quarter section post
Beech 10", S38½°W, 19 Links
Cedar 11", N41½°W, 31 Links

County Road Commission Records - NONE

Recorded Surveys - Brown, 7-18-80, Liber 4, Page 432, 5/8" Re-Rod

Unrecorded Surveys - Brown, 01-12-79, 5/8" Re-Rod
Brown, 1986, 5/8" Re-Rod
Brown, 4-9-96, 5/8" Re-Rod

L.C.R.C. - NONE

County Surveyor Records -
May 11, 1865, C B Cottrell
2 Surveys refer to Corner


Recorded Plats - 2 Plats refer to Corner
SCHOTT AND ROBERTS EDGEWATER SUBDIVISION, Liber 6, Page 50, Black
BURNETTE WOODS SUBDIVISION, Liber 4, Page 58, Leach

B. Description of corner evidence found and/or method applied in restoring or reestablishing corner:

A-6
W 1/4 Cor, Section 18, T16N-R16E
Found 1" Pipe over 5/8" Bar on East Edge of Large Pile of Rocks
Accepted as the best available evidence
of the original corner position
(On Lincoln Road)

C. Description of monument for corner and accessories established to perpetuate locating the position of the corner:

A-6
W 1/4 Cor, Section 18, T16N-R16E
Found 1" Pipe over 5/8" Bar on East Edge of Large Pile of Rocks
N35°E 43.0' to Southwest Corner of Garage
N15°E 29.68' to Nail in 24" Chestnut
N15°W 29.68' to Nail in 24" Chestnut
N30°W 35.25' to Nail in 24" Chestnut
S45°E 47.35' to Nail in Power Pole
North 2628.30' to NW Cor, Sec 18, T16N-R16E
South 2629.36' to SW Cor, Sec 18, T16N-R16E

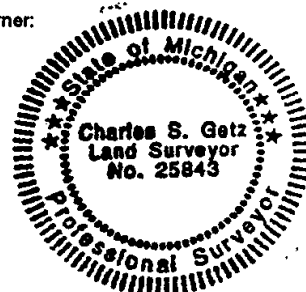

Signed by Charles S. Getz
Surveyor's Michigan License No. 25843

Date September 11, 2000

PEER GROUP APPROVED AT MEETING
HELD September 18, 2000. RLB