

JAN 19 2001

SECTION

2000 REMONUMENTATION

Re Mon. Liber 2, Page 71

LAND CORNER RECORDATION CERTIFICATE
Filing Requirement of Act 74, Mich. P.A. 1970

For corners in

Huron	Located in:	Corner Code #
(County)		
1. Public Land Survey Sand Beach	T16N R16E	A-9
	T R	
	T R	
	T R	
2. Property Controlling in Section	S T R	
	S T R	
3. Miscellaneous Property in Sec.	S T R	
	S T R	

STATE OF MICHIGAN
HURON COUNTY
RECORDED

20 SEP 2000 2:04 PM

FRANCES L. HOLDWICK
REGISTER OF DEEDS

Register of Deeds Stamp & File Number

4. Lot No. _____, Recorded Plat _____
5. Private Claims _____

I, Charles S. Getz, in a field survey on July 18, 2000, do hereby state that under requirements of P.A. 74, Michigan P.A. of 1970, the corner points mentioned in lines 1 and 2 above were in conformance with regulations and rules therefore as required in the current manual of survey instructions of the United States Department of the Interior, Bureau of Land Management or by a decree of a Court of Law and /or that the corner points mentioned in lines 3, 4 and 5 above were in conformance with the rules of the Michigan Board of Land Surveyors or by a Decree of a Court of Law; established, re-established, monumented, recovered, found as expressed below:

NOTE: Not more than 2 corners, all in the same town and range, may be recorded on this certificate.

	A	B	C	D	E	F	G	H	I	J	K	L	N
1													
2	6			5			4			3		2	1
3													
4	7			8			9			10		11	12
5													
6	18			17			16			15		14	13
7													
8	19			20			21			22		23	24
9													
10	30			29			28			27		26	25
11													
12	31			32			33			34		35	36
13													

A. Description of original monument and accessories and/or subsequent restoration:

A-9 1834 G.L.O., H. Parke D.S. County Road Commission Records - Large Stone, 5/8" Steel Pin
Set Post
Hemlock 10", S26°W, 21 Links Recorded Surveys - NONE
Beech 10", N20°W, 21 Links
Unrecorded Surveys - Case, 5-13-96, Mon. box

L.C.R.C. - NONE


County Surveyor Records -
April 2, 1865, C B Cottrell,
Survey refers to Corner

B. Description of corner evidence found and/or method applied in restoring or reestablishing corner:

A-9
SW Cor, Section 19, T16N-R16E
Found 3/4" Bar in Monument Box
Accepted as the best available evidence
of the original corner position
(Intersection of McIntosh Road & Edwards Road)

C. Description of monument for corner and accessories established to perpetuate locating the position of the corner:

A-9
SW Cor, Section 19, T16N-R16E
Found 3/4" Bar in Monument Box in Road Centerlines
S45°E 41.50' to Stop and Road Sign Post
North 34.0' to West Leg of Arrow Sign
S45°W 51.7' to Northeast corner of Telephone Box
North 2643.70' to W 1/4 Cor, Sec 19, T16N-R16E
South 2661.48' to W 1/4 Cor, Sec 30, T16N-R16E

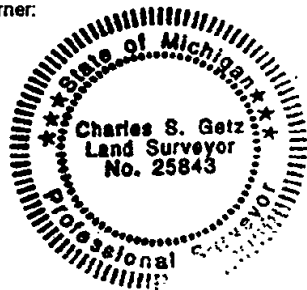

Signed by Charles S. Getz
Surveyor's Michigan License No. 25843

Date July 23, 2000

PEER GROUP APPROVED AT MEETING
HELD September 18, 2000. RLB