

Re-Mon. Liber 2, Page 6

1999 REMONUMENTATION

LAND CORNER RECORDATION CERTIFICATE  
Filing Requirement of Act 74, Mich. P.A. 1970

RECORDED

For Corners in

<u>Huron</u> (County)	Located in:	Corner Code #
1. Public Land survey: <u>Lake</u>	T 18_N R 11_E	<u>D-13</u> ✓
	T _____ R _____	<u>E-13</u>
	T _____ R _____	_____
	T _____ R _____	_____
2. Property Controlling in Section	S _____ T _____ R _____	_____
	S _____ T _____ R _____	_____
3. Miscellaneous Property in Sec.	S _____ T _____ R _____	_____
	S _____ T _____ R _____	_____
4. Lot No. _____, Recorded Plat _____	<b>SECTION</b>	
5. Private Claims _____		

DEC 28 4 18 PM '99

Frances Holmbeck  
REGISTER OF DEEDS  
HURON COUNTY, MICHIGAN

Register of Deeds Stamp & File Number

I, James T. Meek, in a field survey on October 30, 1999, do hereby certify that under requirements of P.A. 74, Michigan P.A. of 1970, the corner points mentioned in lines 1 and 2 above were in conformance with regulations and rules thereof as required in the current manual of survey instructions of the United States Department of the Interior, Bureau of Land Management or by a decree of a Court of Law and/or that the corner points mentioned in lines 3, 4 and 5 above were in conformance with the rules of the Michigan Board of Land Surveyors or by a Decree of a Court of Law; established, re-established, monumented, re-monumented, recovered, found as expressed below:

A	B	C	D	E	F	G	H	I	J	K	L	M
2	6	5	4	3	2	1						
3												
4	7	8	9	10	11	12						
5												
6	18	17	16	15	14	13						
7												
8	19	20	21	22	23	24						
9												
10	30	29	28	27	26	25						
11												
12	31	32	33	34	35	36						
13												

NOTE: Not more than 2 corners, all in the same town and range, may be recorded on this certificate.

A. Description of original monument and accessories and/or subsequent restoration:

Original survey, South Bdy. T18NR11E, 1835, Harvey Parke D.S.

D-13 South ¼ Corner of Section 32  
Post  
Elm 36", N37°W, 31 links  
Beech 9", N74°E, 22 links

E-13 Corner of Sections 32 and 33  
Post  
Hemlock 9", N66°E, 60 links  
Hemlock 30", N73°W, 31 links

County Surveyor's Record: none  
Recorded Surveys: L5, P232  
LCRC: none

County Surveyor's Record: Axle over old post  
Recorded Surveys: L3, P161  
LCRC: none

B. Description of corner evidence found and/or method applied in restoring or reestablishing corner:

D-13 South ¼ Corner of Section 32  
  
Found no evidence of the original corner position.  
Set ½" iron in mon box based on Liber 5, Page 232 Huron County Records

E-13 Corner of Sections 32 and 33  
  
Found ½" iron in mon box  
Accepted as the best available evidence of the original corner position.


C. Description of monument for corner and accessories established to perpetuate locating the position of the corner:

D-13 South ¼ Corner of Section 32  
  
½" iron in mon box  
  
From which:  
¾" iron in mon box bears East, 11.72'  
½" iron bears S45°E, 20.4'  
½" iron bears N45°W, 20.69'  
½" iron bears N45°E, 20.0'

E-13 Corner of Sections 32 and 33  
  
½" iron in mon box  
  
From which:  
Stop sign post bears N10°E, 76.8'  
Tag in PP bears S20°E, 57.7'  
Stop sign post bears S10°W, 46.9'  
Road sign post bears N60°W, 47.7'

Signed by [Signature]  
Surveyor's Michigan License No. 39089

Date 12-21-99

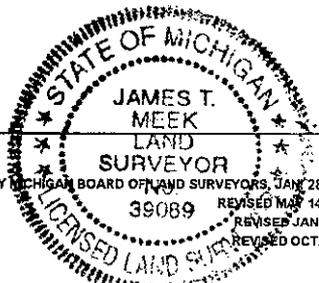

APPROVED AT PEER BOARD MEETING 12-16-99 RLB