

LAND CORNER RECORDATION CERTIFICATE
Filing Requirement of Act 74, Mich. P.A. 1970

For corners in

Huron

(County)

Located in:

Corner Code #

1. Public Land Survey	Dwight	T18N R13E	C-13
		T R	
		T R	
		T R	
		T R	
2. Property Controlling in Section	S	T R	
	S	T R	
3. Miscellaneous	S	T R	
Property in Sec.	S	T R	

STATE OF MICHIGAN
HURON COUNTY
RECORDED

28 OCT 99 9:11 A.M.

FRANCES L. HOLDWICK
REGISTER OF DEEDS

Register of Deeds Stamp & File Number

4. Lot No. _____, Recorded Plat _____
5. Private Claims _____

I, Charles S. Getz, in a field survey on April 12, 1999 do hereby state that under requirements of P.A. 74, Michigan P.A. of 1970, the corner points mentioned in lines 1 and 2 above were in conformance with regulations and rules therefore as required in the current manual of survey instructions of the United States Department of the Interior, Bureau of Land Management or by a decree of a Court of Law and/or that the corner points mentioned in lines 3, 4 and 5 above were in conformance with the rules of the Michigan Board of Land Surveyors or by a Decree of a Court of Law; established, re-established, monumented, recovered, found as expressed below:

NOTE: Not more than 2 corners, all in the same town and range, may be recorded on this certificate.

	A	B	C	D	E	F	G	H	I	J	K	L	M
1													
2		6		5		4		3		2		1	
3													
4		7		8		9		10		11		12	
5													
6		18		17		16		15		14		13	
7													
8		19		20		21		22		23		24	
9													
10		30		29		28		27		26		25	
11													
12		31		32		33		34		35		36	
13													

A. Description of original monument and accessories and/or subsequent restoration:

C-13 1834 G.L.O., H. Parke D.S.

County Road Commission Records - Iron Pin in Cedar Post

Set Post

Cedar 8", N37°E, 22 Links

Do. 11", N57°W, 26 Links

Recorded Surveys -

Case, 8-23-78, Liber 3, Page 537, 3/4" steel pin in Mon. box in place

Case, 8-23-78, Liber 3, Page 541, 3/4" steel pin in Mon. box in place

Case, 12-2-92, Liber 5, Page 92, 3/4" steel pin in Mon. box in place

L.C.R.C. - NONE

Unrecorded Surveys -

Case, 1992, 3/4" steel pin in Mon. Box.

Case, 2-27-98, 3/4" steel pin in Mon. box in place.

County Surveyor Records -

NONE

B. Description of corner evidence found and/or method applied in restoring or reestablishing corner:

C-13

SW Cor, Section 32, T18N-R13E

Found 3/4" Steel Pin in Monument Box

Accepted as the best available evidence

of original corner position

(Intersection of Kinde Road & Crockard Road)

C. Description of monument for corner and accessories established to perpetuate locating the position of the corner:

C-13

SW Cor, Section 32, T18N-R13E

Found 3/4" Steel Pin in Monument Box

N30°W 42.70' to Leg of Stop Sign

South 27.25' to East Leg of Road Sign

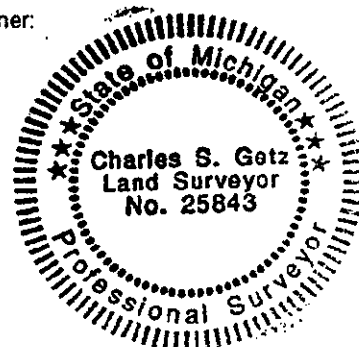
S50°W 74.85' to Power Pole

West 88.90' to Monument Box

N65°E 98.90' to Nail in Power Pole

West 2628.15' to S 1/4 Cor, Sec 31, T18N-R13E

East 2627.60' to S 1/4 Cor, Sec 32, T18N-R13E

Signed by Charles S. GetzDate August 14, 1999Surveyor's Michigan License No. 25843PEER GROUP APPROVED AT MEETING R.R.B.
HELD October 26, 1999.