


126322

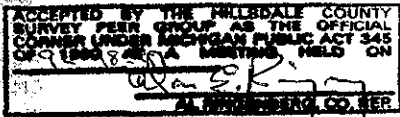

LIBER 3 PAGE 182

HILLSDALE COUNTY REMONUMENTATION CORNER
LAND CORNER RECORDATION CERTIFICATE
Filing Requirement of Act 74, Mich. P.A. 1970

RECORDED
HILLSDALE CO. MICH.
'97 SEP 22 PM 12 17

Judy VanZandt
REG. OF DEEDS

For corners in

HILLSDALE	Located In:	Corner
Code #		
(County)		
ALLEN		
1. Public Land Survey	T 6 S R 4 W	G-10
	T R	
	T R	
	T R	
2. Property Controlling	S T R	
in Section	S T R	
3. Miscellaneous	S T R	
Property in Sec.	S T R	

Register of Deeds Stamp & File Number

4. Lot No. _____, Recorded Plat _____
5. Private Claims _____

I, EDWARD W. REED, in a field survey on JULY 18, 1997 do hereby state that under requirements of P.A. 74, Michigan P.A. of 1970, the corner points mentioned in lines 1 and 2 above were in conformance with regulations and rules therefore as required in the current manual of survey instructions of the United States Department of the Interior, Bureau of Land Management or by a decree of a Court of Law and /or that the corner points mentioned in lines 3, 4 and 5 above were in conformance with the rules of the Michigan Board of Land Surveyors or by a Decree of a Court of Law; established, re-established, monumented, recovered, found as expressed below:

NOTE: Not more than 2 corners, all in the same town and range, may be recorded on this certificate.

	A	B	C	D	E	F	G	H	I	J	K	L	M
1													
2	6		5		4		3		2		1		
3													
4	7		8		9		10		11		12		
5													
6	18		17		16		15		14		13		
7													
8	19		20		21		22		23		24		
9													
10	30		29		28		27		26		25		
11													
12	31		32		33		34		35		36		
13													

A. Description of original monument and accessories and/or subsequent restoration:
QUARTER CORNER COMMON TO SECTIONS 27-28

1959: CORNER RESET BY AJ HATT, SURVEYOR
CORNER USED BY AND WITNESSED BY RINGENBERG & BURRIS, FOUND 5/8" IRON BAR

B. Description of corner evidence found and/or method applied in restoring or reestablishing corner:
FOUND 5/8" IRON BAR 24" DEEP FITTING 2 OLD WITNESS OF RINGENBERG & BURRIS

SURVEY &
REMONUMENTATION
FEB 11 1998

C. Description of monument for corner and accessories established to perpetuate locating the position of the corner:
SECTION
SET 3/4"X30" REBAR IRON AND REMON CAP IN CI-MONUMENT BOX FLUSH WITH ROAD SURFACE

12" WALNUT (NOW STUMP 4' HIGH) SOUTH 37.2'
36" MAPLE S60E 72.15'
EAST END DRIVE CULVERT N40W 50.7"
WEST END DRIVE CULVERT N40E 42.9'
WEST END DRIVE CULVERT S14E 24.0'
NW CORNER HOUSE S38E 139.00'

AND IS ACCEPTED AS A CAREFUL AND FAITHFUL PERPETUATION OF THE POSITION OF THE ORIGINAL CORNER

Signed by Edward W. Reed Date JULY 18, 1997
EDWARD W. REED
Surveyor's Michigan License No. 33985

