



LIBER 5 PAGE 44

HILLSDALE COUNTY REMONUMENTATION  
LAND CORNER RECORDATION CERTIFICATE  
Filing Requirement of Act 74, Mich. P.A. 1970

RECORDED 035912  
HILLSDALE CO. MICH.

00 NOV 13 AM 11:09

Judy VanZandt  
REG. OF DEEDS

For corners in

HILLSDALE

(County)

Located In:

Corner Code #

PITTSFORD TWP.

1. Public Land Survey

T7S R1W D-7

T R

T R

T R

2. Property Controlling  
in Section

S T R

S T R

3. Miscellaneous

S T R

Property in Sec.

S T R

SURVEY &  
REMONUMENTATION

JAN 18 2001

SECTION

Register of Deeds Stamp & File Number

4. Lot No. , Recorded Plat

5. Private Claims

I, Frederick J. Cutcher, in a field survey on Oct. 21 2000 do hereby state that under requirements of P.A. 74, Michigan P.A. of 1970, the corner points mentioned in lines 1 and 2 above were in conformance with regulations and rules therefore as required in the current manual of survey instructions of the United States Department of the Interior, Bureau of Land Management or by a decree of a Court of Law and for that the corner points mentioned in lines 3, 4 and 5 above were in conformance with the rules of the Michigan Board of Land Surveyors or by a Decree of a Court of Law; established, re-established, monumented, recovered, found as expressed below:

NOTE: Not more than 2 corners, all in the same town and range, may be recorded on this certificate.

|    | A  | B | C  | D | E  | F | G  | H | I  | J | K  | L | M |
|----|----|---|----|---|----|---|----|---|----|---|----|---|---|
| 1  |    |   |    |   |    |   |    |   |    |   |    |   |   |
| 2  | 6  |   | 5  |   | 4  |   | 3  |   | 2  |   | 1  |   |   |
| 3  |    |   |    |   |    |   |    |   |    |   |    |   |   |
| 4  | 7  |   | 8  |   | 9  |   | 10 |   | 11 |   | 12 |   |   |
| 5  |    |   |    |   |    |   |    |   |    |   |    |   |   |
| 6  | 18 |   | 17 |   | 16 |   | 15 |   | 14 |   | 13 |   |   |
| 7  |    |   |    |   |    |   |    |   |    |   |    |   |   |
| 8  | 19 |   | 20 |   | 21 |   | 22 |   | 23 |   | 24 |   |   |
| 9  |    |   |    |   |    |   |    |   |    |   |    |   |   |
| 10 | 30 |   | 29 |   | 28 |   | 27 |   | 26 |   | 25 |   |   |
| 11 |    |   |    |   |    |   |    |   |    |   |    |   |   |
| 12 | 31 |   | 32 |   | 33 |   | 34 |   | 35 |   | 36 |   |   |
| 13 |    |   |    |   |    |   |    |   |    |   |    |   |   |

A. Description of original monument and accessories and/or subsequent restoration:

GLO, Robert Clark, Jr., 1824: Set Quarter Section Post at average distance; Sugar 30" S. 15° W. 16 lks.; Beech 24" N. 30° E. 14 lks.

Geo. Mark, Mar. 29, 1875, Survey #691: Stone & Brick; Butternut 12" South 53 lks.; Butternut 10" N. 75° W 139-1/2 lks.

Description of corner evidence found and/or method applied in restoring or reestablishing corner:

None of the Above was found. Set corner 1/2 way and on line with C-7 and E-7.

⊙ M=2630.46 ⊙ M=2630.46 ⊙  
C-7 GLO=2630.76 D-7 GLO=2630.76 E-7  
MARKS=2624.33 MARKS=2629.44

C. Description of monument for corner and accessories established to perpetuate locating the position of the corner:

Set 3/4"x 30" iron with remonumentation cap in monument box and is accepted as the best available evidence of the position of the original corner.

1.8' North of centerline M-34 and in line with field line to North.

Set nail & spotter 30" Oak N. 28° W. 33.70'


Set nail & spotter pwr. Pole S. 36° W. 57.27'

Set nail & spotter R.R. tie end post S. 50° E. 86.37'

Top cen. tel. stan. S. 48° E. 79.55'

Signed by Frederick J. Cutcher

Surveyor's Michigan License No. 24592

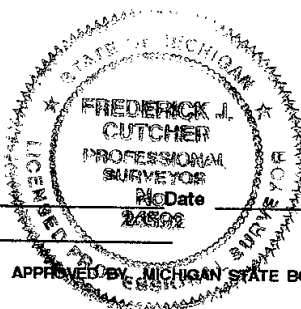

11/9/2000