



LIBER 5 PAGE 50

035918

RECORDED
HILLSDALE CO. MICH.

00 NOV 13 AM 11:09

HILLSDALE COUNTY REMONUMENTATION
LAND CORNER RECORDATION CERTIFICATE
Filing Requirement of Act 74, Mich. P.A. 1970

Julie VanZandt
REG. OF DEEDS

SURVEY &
REMONUMENTATION

JAN 12 2001

SECTION

Register of Deeds Stamp & File Number

For corners in

HILLSDALE

(County)

Located in:

Corner Code #

PITTSFORD TWP.

- | | | | |
|------------------------------------|-----|-----|-----|
| 1. Public Land Survey | T7S | R1W | J-7 |
| | T | R | |
| | T | R | |
| | T | R | |
| 2. Property Controlling in Section | S | T | R |
| | S | T | R |
| 3. Miscellaneous Property in Sec. | S | T | R |
| | S | T | R |

4. Lot No. _____, Recorded Plat _____
5. Private Claims _____

I, Frederick J. Cutcher, in a field survey on Nov. 8, 2000 do hereby state that under requirements of P.A. 74, Michigan P.A. of 1970, the corner points mentioned in lines 1 and 2 above were in conformance with regulations and rules therefore as required in the current manual of survey instructions of the United States Department of the Interior, Bureau of Land Management or by a decree of a Court of Law and for that the corner points mentioned in lines 3, 4 and 5 above were in conformance with the rules of the Michigan Board of Land Surveyors or by a Decree of a Court of Law; established, re-established, monumented, recovered, found as expressed below:

NOTE: Not more than 2 corners, all in the same town and range, may be recorded on this certificate.


	A	B	C	D	E	F	G	H	I	J	K	L	M
1													
2		6		5		4		3		2		1	
3													
4		7		8		9		10		11		12	
5													
6		18		17		16		15		14		13	
7													
8		19		20		21		22		23		24	
9													
10		30		29		28		27		26		25	
11													
12		31		32		33		34		35		36	
13													

A. Description of original monument and accessories and/or subsequent restoration:

GLO, Robert Clark, Jr., 1824: Set Quarter Section Post at average distance; Beech 16" S. 38° E. 17 lks.; Beech 18" N. 65° W. 16 lks.

Description of corner evidence found and/or method applied in restoring or reestablishing corner:

No evidence of corner found. Set 1/2 way between I-7 and K-7 and in centerline of M-34 to fit local occupation. (See L. 718, P 374, Deeds).

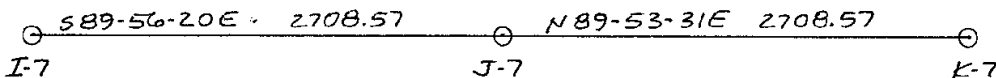

C. Description of monument for corner and accessories established to perpetuate locating the position of the corner:

Set 3/4" x 30" iron with remonumentation cap in monument box and is accepted as the best available evidence of the position of the original corner.

In centerline M-34.

S.W. corner Thorn headstone N. 28° E. 55.85'

N.E. corner old school house foundation S. 40° W. 64.25'

cen. 5" Maple S. 25° E. 58.74'

S.E. cor. Emeline headstone N. 20° W. 48.48'

cen. 6" Maple S. 12° W. 51.92'



Signed by *Frederick J. Cutcher*

Date 11/13/2000

Surveyor's Michigan License No. 24592