



LIBER 3 PAGE 107

107800

RECORDED
HILLSDALE CO. MICH.

REMONUMENTATION

LAND CORNER RECORDATION CERTIFICATE

Filing Requirement of Act 74, Mich. P.A. 1970

'95 DEC 21 PM 3 41

John E. Maxson
REG. OF DEEDS

SURVEY &
REMONUMENTATION

JAN 30 1996

Register of Deeds Stamp & File Number
COMMISSION

For corners in
HILLSDALE

(County)

Located In:

Corner Code #

7S 2W

H-3

1. Public Land Survey

T R

T R

T R

T R

2. Property Controlling
in Section

S T R

S T R

3. Miscellaneous
Property in Sec.

S T R

S T R

4. Lot No. , Recorded Plat

5. Private Claims

JOHN MAXSON

28 NOVEMBER

19 95

I, JOHN MAXSON, in a field survey on 28 NOVEMBER, 19 95, do hereby certify that under requirements of P.A. 74, Michigan P.A. of 1970, the corner points mentioned in lines 1 and 2 above were in conformance with regulations and rules therefore as required in the current manual of survey instructions of the United States Department of the Interior, Bureau of Land Management or by a decree of a Court of Law and/or that the corner points mentioned in lines 3, 4 and 5 above were in conformance with the rules of the Michigan Board of Land Surveyors or by a Decree of a Court of Law; established, re-established, monumented, re-monumented, recovered, found as expressed below:

NOTE: Not more than 4 corners, all in the same town and range, may be recorded on this certificate.

A. Description of original monument and accessories and/or subsequent restoration:

1825 GLO WILLIAM BROOKFIELD
POST
N58W 64 lks 13" W.OAK
N09W 74 lks 14" W.OAK

1876 GEORGE MARK
20" STONE, IRON
N19W 28 lks 10" HICKORY
S01W 44.75 lks 6" HICKORY

1972 ROBERT BURRIS
LCRC L1 P171
SURVEY L1 P127
R.R. SPIKE
N25E 29.52' P.POLE
S07W 47.65' 30" OAK
N30W 40.62' 20" FIR

1974 RUSSELL COLE
SURVEY L1 P389
R.R. SPIKE
NNW 40.67' 24" FIR
NW 33.94' 24" FIR
NNE 29.93' P.POLE

	A	B	C	D	E	F	G	H	I	J	K	L	M
2	6	5	4	3	2	1							
3													
4	7	8	9	10	11	12							
5													
6	18	17	16	15	14	13							
7													
8	19	20	21	22	23	24							
9													
10	30	29	28	27	26	25							
11													
12	31	32	33	34	35	36							
13													


B. Description of corner evidence found and/or method applied in restoring or reestablishing corner:

FOUND R.R. SPIKE AS WITNESSED FROM LCRC'S. THE R.R. SPIKE WAS 2 FEET SOUTH OF CENTERLINE OF ROAD AND IN LINE OF OCCUPATION GOING NORTH AND SOUTH. NO STONE WAS FOUND. ACCEPTED AS THE BEST AVAILABLE EVIDENCE OF THE POSITION OF THE ORIGINAL CORNER.

C. Description of monument for corner and accessories established to perpetuate locating the position of the corner:

SET 5/8" X 36" REBAR W/CAP

N24W 41.28' 28" FIR
N05E 34.11' 28" FIR
N31E 30.03' P.POLE
SOUTH 35.08' FNC. POST

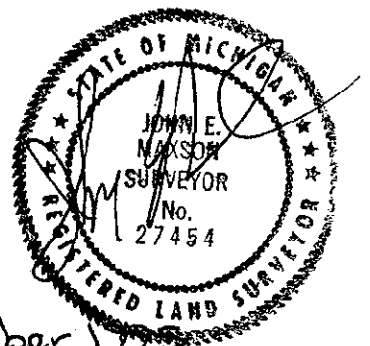

Signed by John E Maxson

Date 21 December 1995

Surveyor's Michigan License No. 27454