

118869

RECORDED
HILLSDALE CO. MICH.

REMONUMENTATION
LAND CORNER RECORDATION CERTIFICATE
Filing Requirement of Act 74, Mich. P.A. 1970

'97 JAN 13 AM 11 56

Judy VanZandt
REG. OF DEEDS

For corners in
HILLSDALE
(county)

Located In


Corner Code #

- | | | | |
|---------------------------|------|------|-----|
| 1. Public Land Survey | T 9S | R 2W | F-3 |
| | T | R | |
| | T | R | |
| | T | R | |
| 2. Property Controlling S | T | R | |
| In Section | S T | R | |
| 3. Miscellaneous | S T | R | |
| Property in Sec. | S T | R | |

Register of Deeds Stamp & File Number

4. Lot No. _____, Recorded Plat _____
5. Private Claims _____

I, R.T. Tietsema, in a field survey on SEPTEMBER 19, 1996, hereby certify that under the requirements of P.A. 74, Michigan P.A. of 1970, the corner points mentioned in lines 1 and 2 above were in conformance with the regulations and rules therefore as required in the current manual of survey instructions of the United States Department of the Interior, Bureau of Land Management of by a decree of a Court of Law and/or that the corner points mentioned in lines 3, 4, and 5 above were in conformance with the rules of the Michigan Board of Land Surveyors or by a Decree of a Court of Law; established, re-established, monumented, recovered, found as expressed below.

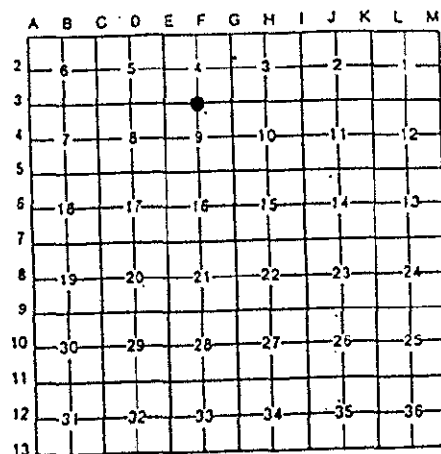

NOTE: Not more than 4 corners, all in the same town and range, may be recorded on this certificate

A. Description of original monument and accessories and/or restoration:

Set post Corner of Sections 4, & 9

02/30/1825	GLO (Brookfield)	Fld. Notes	Set Original Corner	1) 18" Beech S23W	80 links(52.8')
				2) 14" Beech S53 1/2E	41 links(27.06')
August 1957	D.C.P. P.S.# 3165	Resurvey	Found 1/2" Pipe	3) 17" Twin Elm N00E	51.82'
				4) 25" Elm S72W	51.05'
				5) 12" Elm S40E	33.07'

B. Description of corner evidence found and/or method applied in restoring or reestablishing corner:

In September 1996, LSC was unable to find this corner or any of its accessories. Set corner on line between corners E-3 and G-3 at the intersection of the occupation line to the South.

C. Description of monument for corner and accessories established to perpetuate locating the position of the corner:

Set 1/2" Rebar with Remon Cap in Mon Box, established four (4) witnesses.

- | | | |
|------------------------|------|--|
| 6) Power Pole | S00E | 29.43' to P.K. in east side of pole. |
| 7) Twin 12" Willow | S15W | 43.29' to P.K. in East side of East trunk. |
| 8) SE Cor. Conc. Hdwl. | N10E | 29.40' |
| 9) NE Cor. Conc. Hdwl. | S10E | 21.38' |

SURVEY &
REMONUMENTATION

MAY 16 1997

REMONUMENTATION

It is our opinion that this is a careful and faithful reestablishment of the position of the original corner.

Signed by [Signature] Date DEC 20 1996
Surveyor's Michigan License No. 20712