

SURVEY & REMONUMENTATION

LIBER

8 PAGE 264

FILED

APR 10 1995

LAND CORNER RECORDATION CERTIFICATE

Filing Requirement of Act 74, Mich. P.A. 1970

OCT 26 11 41 AM '94

REGISTER OF DEEDS

INGHAM COUNTY, MICH.

For corners in

COMMISSION

INGHAM (County)

Located In:

Corner Code #

STOCKBRIDGE TOWNSHIP

1. Public Land Survey

T 1N R 2E

G-2

2. Property Controlling in Section

S T R

3. Miscellaneous Property in Sec.

S T R

4. Lot No. , Recorded Plat

5. Private Claims

Register of Deeds Stamp & File Number

I, David Clifford, in a field survey on April 16, 19 94, do hereby certify that under requirements of P.A. 74, Michigan P.A. of 1970, the corner points mentioned in lines 1 and 2 above were in conformance with regulations and rules therefore as required in the current manual of survey instructions of the United States Department of the Interior, Bureau of Land Management or by a decree of a Court of Law and/or that the corner points mentioned in lines 3, 4 and 5 above were in conformance with the rules of the Michigan Board of Land Surveyors or by a Decree of a Court of Law; established, re-established, monumented, re-monumented, recovered, found as expressed below:

NOTE: Not more than 4 corners, all in the same town and range, may be recorded on this certificate.

A. Description of original monument and accessories and/or subsequent restoration:

1. Original Post Set by J. Wampler D.S. in Nov. 1825

B. Oak 20" S43E 50

W. Oak 8" S73E 55

2. T.J. Brown Co. Surv. used corner in a Survey recorded in Vol. 2 pg 351 in Jan. 1858 with no mention of mon. or witnesses.

(OVER)

B. Description of corner evidence found and/or method applied in restoring or reestablishing corner:

Searched at apparent location at corner and found $\frac{1}{2}$ " bar with cap #13574 at South base of anchor post with all of my 1988 witnesses still standing. The 36" Oak stump in the N.E. Quad is almost certainly Yocum's 1878 witness. Pulled 24.4' feet from point on stump that would have been face of 12" Oak and intersected Anchor post at South base. Excavated all around post and found only stones. Excepted post as perpetuation of corner and replaced $\frac{1}{2}$ " bar with standard bar and cap. Measured North 2406.94 to G-1. Measured South 2655.02 to G-3.

C. Description of monument for corner and accessories established to perpetuate locating the position of the corner:


Standard Ingham County $\frac{3}{4}$ " Bar with PA 345 Cap #25837 at South base anchor post.

Set Nail & Tag #25837 in W. Side 10" Cherry 32° Naz 20.62'

Set Nail & Tag #25837 in N. Side 18" Oak 116° Naz 50.50'

Set Nail & Tag #25837 in S. Side 14" Cherry 296° Naz 22.70'

Set Nail & Tag #25837 in S. Side 24" Oak 274° Naz 44.25'

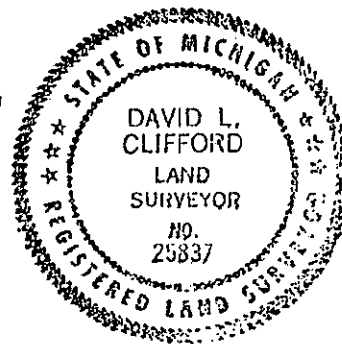

Signed by

David Clifford

Date August 9 1994

Surveyor's Michigan License No.

25837

2680

P.A. 345 INGHAM COUNTY

FORM APPROVED BY MICHIGAN STATE BOARD OF LAND SURVEYORS, JAN. 28, 1988
REVISED MAY 14, 1991
REVISED JAN. 1994

8/10/94 AL

3. J. Yokum former Washtenaw County Surveyor witnessed corner in 1878 and recorded them in his private records (now in possession of Wolverine Engineering) as an iron.
W.O. 12" N49E 37lks(24.4')
W.O. 20" S72W 55lks(36.3')
4. G. Young LS #17640 Recorded Corner in July 1976 in L3 of Corners page 593 and used in surveys dated June 1972 recorded in Liber 1 of Surveys page 343 and July 1976 recorded in Liber 2 of Surveys page 819 as a found Anchor post
Spk in 24" Oak S.E. 49.60'
Spk in 30" Oak N.E. 23.70'
Spk in 8" Cherry WNW
5. A. Williams LS #21275 used corner in a survey in June 1978 recorded in Liber 3 of Surveys page 368 with same mon. and witnesses as in item 4.
6. Corner recovered by this Surveyor during Super Collider Project in Oct. 1988 Found capped iron #13574 (Oscar Boss) at South Edge Anchor Post
Spike in 8" Cherry WNW 22.25
Spike in 8" Cherry N20°E 20.75'
Spike in 36" Oak Stump N.E. 23.70'
Spike in 24" Oak S.E. 50.00'
7. B. Antcliff L.S. #25826 used corner on Surveys during Super Collider Project in Oct. 1988 and recorded in Liber 5 of Surveys pages 790-793, 812-831 and 840-843 with same mon. and witnesses as in item #6
8. R. Helsel LS # 18994 used corner on a survey in Oct. 1993 (Liber 7 page 28) with same mon. and witnesses as item 6