

DEC 17 1998

SECTION

LAND CORNER RECORDATION CERTIFICATE
Filing Requirement of Act 74, Mich. P.A. 1970

Liber 9 Page 379

For corners in

INGHAM Located In: LOCKE TOWNSHIP Corner Code #
(County)

1. Public Land Survey T 4N R 2E M-11
T R
T R
T R

2. Property Controlling S T R
in Section S T R

3. Miscellaneous S T R
Property in Sec. S T R

FILED

980053156
10/19/1998 14:42:08
REGISTER OF DEEDS
Paula Johnson
INGHAM COUNTY, MI

Register of Deeds Stamp & File Number

4. Lot No. , Recorded Plat
5. Private Claims

I, RON HELSEL, in a field survey on SEPTEMBER 1, 1998 do hereby certify that under requirements of P.A. 74, Michigan P.A. of 1970, the corner points mentioned in lines 1 and 2 above were in conformance with regulations and rules therefore as required in the current manual of survey instructions of the United States Department of the Interior, Bureau of Land Management or by a decree of a Court of Law and /or that the corner points mentioned in lines 3, 4 and 5 above were in conformance with the rules of the Michigan Board of Land Surveyors or by a Decree of a Court of Law; established, re-established, monumented, re-monumented, recovered, found as expressed below:

NOTE: Not more than 4 corners, all in the same town and range, may be recorded on this certificate.

A. Description of original monument and accessories and/or subsequent restoration:
ORIGINAL MONUMENT: POST SET BY AN UNKNOWN, U.S. DEPUTY SURVEYOR, FEB., 1824. THE EAST LINE OF LOCKE TOWNSHIP WAS SURVEYED FROM NORTH TO SOUTH. MAPLE 4" N37 1/2W 8 LINKS
MAPLE 3" S48 1/2W 14 1/2 LINKS

1) COUNTY SURVEYOR JOHN McCREARY DID NOT REFER TO THIS CORNER IN A SURVEY OF SECTION 36, VOL. 2, PAGE 235, DATED MAY 1890.
2) P.A. 132 SURVEYS, RECORDED IN LIBER 2, PAGES 432-436, AUG. 4, 1975 BY L. HENDRYX NO. 3276, REFERRED TO THIS CORNER AND SUBSEQUENTLY, RECORDED IN P.A. 74, OF SAME FIELD DATE, BUT RECORDED ON JULY 7, 1978. CALLED FOR A GAS PIPE AS FOUND. #4 IRON W 33.0 (FOUND)
TAG 14" WALNUT NW 38.1 (FOUND)
TAG 12" MAPLE SE 47.32 (GONE)
GAS PIPE S 64.2 (FOUND A-11, CONWAY TWP.)

3) P.A. 74 CORNER RECORDED IN LIBER 5, PAGE 32, R. LESTER NO. 18998, FIELD DATED AUG. 16, 1978. THE INGHAM CO. CETA CREW EXCAVATED A 5' BY 5' HOLE TO AN AVERAGE DEPTH OF 2.5 FEET. CORNER WAS ACCEPTED AS RECORDED BY L. HENDRYX.


SET 4" X 36" CONCRETE MONUMENT WITH 1/2" X 38" REROD AND CAP NO. 18998 IN POSITION OF A 1" GAS PIPE.

NAIL & TAG, # 18998, EAST SIDE 15" WALNUT, NW, 38 19' (FOUND)
NAIL & TAG, # 18998, NORTH SIDE 8" MAPLE, WEST 17.90' (GONE)
NAIL & TAG, # 18998, EAST SIDE 10" MAPLE, ESE, 47.83' (GONE)
NAIL & TAG, # 18998, WEST SIDE 22" OAK, WSW, 57.59' (GONE)
FOUND 1" PIPE, A-11, CONWAY TWP., T4N, R3W, SOUTH, 64.28' NOTE: G.L.O. FALLING 67.98 FEET
(CONTINUED ON BACK)

B. Description of corner evidence found and/or method applied in restoring or reestablishing corner:
FOUND THE 4" CONCRETE MONUMENT AS DESCRIBED BY SURVEYOR R. LESTER IN 3-A ABOVE, WITH CAP EMBOSSED WITH # 18998. CORNER LOCATED 2' WEST OF THE C/L OF HERRINGTON ROAD ON AN EXTENDED FENCE LINE TO THE WEST. THE WALNUT TREE WAS THE ONLY REMAINING BEARING TREE STILL STANDING FROM THE WITNESSES SET BY LESTER ALONG WITH A BAR & CAP (illegible) LOCATED AT A-11 OF CONWAY TWP. ALSO FOUND A L. HENDRYX BAR AND CAP 33.12 FEET, WEST. ACCEPTED THE POSITION OF THIS MARKER AND SET A STANDARD DISK ON TOP STAMPED INGHAM CO., P.A. 345, PS NO. 18994.

C. Description of monument for corner and accessories established to perpetuate locating the position of the corner:
STANDARD DISK OVER MONUMENT 2 FEET WEST OF C/L HERRINGTON ROAD.
SOUTH, 64.28 FEET, 1/2" BAR AND CAP (ILLEGIBLE) CONWAY TWP. T4N, R3E, (A-11)
WEST, 33.12 FEET, 1/2" REBAR AND CAP NO. 3276 IN FENCE LINE.
FOUND NAIL AND TAG NO. 18998, NE/SIDE 16" WALNUT, AZ. 316°, 38.53 FEET
SET NAIL & TAG NO. 18994, N/SIDE 12" OAK, AZ. 85°, 38.11 FEET
FOUND BOSS BAR & CAP NO. 17022, AZ. 133°, 46.65 FEET
SET NAIL & TAG NO. 18994, E/SIDE, 26" OAK, AZ. 23°, 81.47 FEET
MEASURED SOUTH, 2639.00 TO M-12

Signed by Ron Helsel Date Oct 2, 1998
Surveyor's Michigan License No. 18994

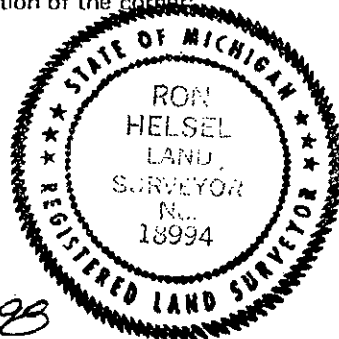

P.A. 345 INGHAM COUNTY
PEER APPROVED 9/22/98 M

DEC 17 1998

SECTION

- 4) P.A. 132 SURVEY RECORDED IN LIBER 6, PAGES 954 & 955 ALONG WITH A P.A. 74 CORNER, RECORDED IN LIBER 7, PAGE 260, G. BOSS NO. 17022, DEC. 24, 1991 WERE WITNESSED AS "FOUND 1/2" REROD"
WEST, 33.12' FD. IRON & CAP # 3276 (FOUND)
S40°E 46.65' FD. BOSS IRON (FOUND)
N50°W 38.53' FD. NAIL & TAG #18998 NE/S 16" WALNUT (FOUND)
N80°E 38.11' SET NAIL & TAG N/S TRIPLE 10" MAPLE (FOUND BOSS TAG ON GROUND; NORTH SIDE OF 10" TRIPLE OAK)
- 5) A P.A. 132 SURVEY RECORDED IN LIBER 7, PAGES 616-617, JAN. 31, 1995, BY M. MAHIEU, NO. 28414, CITED THE SAME WITNESSES AS THE L.C.R.C IN 4-A ABOVE.

RECORDED
INDEXED
SERIALIZED
FILED
DEC 17 1998
LIBRARY
FBI - MEMPHIS

2000 2-14-20