
SURVEY & REMONUMENTATION

∎rveyor's Michigan License No. ____

OCT 1 1 1994 LAND CORNER RECORDATION CERTIFICATE COMMISSION Filing Requirement of Act 74, Mich. P.A. 1970 For corners in Located In: Corner Code ## Ionia (County) T_7N_R_8W Public Land Survey Property Controlling in Section Miscellaneous Register of Deeds Stamp & File Number Property in Sec. __ , Recorded Plat _ Private Claims _ October 25 Marinus Mulder _ , in a field survey on . To hereby certify that under requirements of P.A. 74, Michigan P.A. of 1970, the corner points mentioned n lines 1 and 2 above were in conformance with regulations and rules therefore as required in the Durrent manual of survey instructions of the United States Department of the Interior, Bureau of Land -Nanagement or by a decree of a Court of Law and/or that the corner points mentioned in lines 3, 4 and 5 above were in conformance with the rules of the Michigan Board of Land Surveyors or by a Decree of a Dourt of Law; established, re-established, monumented, re-monumented, recovered, found as 10 ∋xpressed below: 11 -IOTE: Not more than 4 corners, all in the same town and range, may be recorded on this certificate. 12 Description of original monument and accessories and/or subsequent restoration: This corner was first established by U.S. Deputy Surveyor, Lucious Lyon in 1826. A wood post was set witnessed by a 7" White Oak N 66° E 43 links and a 5" Black Oak N 85 1/2° W 13 links. Perpetuation: D.C. Crawford former Ionia County Surveyor has marginal witness notes: for I-13 found in the County Surveyors G.L.O. notes. He states: 1889, 10" Maple Southwest 113 links and 6" Black Oak East 46 links. Also he states: 1911, Maple still standing and Black Oak stump standing. The G.L.O. jog distance from I-13 to the Northeast corner of Section 3 T6N-R8W is West 47 links (I-13 being East of closing corner). Crawford did not state what was set for the corner. Description of corner evidence found and/or method applied in restoring or reestablishing corner: This position falls in a gravel road T intersection. Excavated area and found a large flat white stone on edge with smaller stones and broken glass from bottles around large stone 14" deep. Crawford's witness trees from 1911 are gone. Set 3/4" x 24" rod with a 2 3/4" diameter cap next to large flat stone. Also found a 1/2" rod 0.71' South and 0.67' West of the 3/4" rod which was set. Accepted the stone's as the correct position for I-13. Description of monument for corner and accessories established to perpetuate locating the position of the corner Set 3/4" x 24" steel rod with a 2 3/4" cap stamped "P.S. 25863" next to a large flat stone witnessed by: Ratified by Peer Group Square nail Southwest side power pole N 30° W 89.30' Nail & tag Northeast side 26" Elm 5 33° E 39.47' Nail & tag Northwest side 8" Maple N 35° E 46.06' P.A. 345 Ionia County FIGURE Nail & tag Southeast side wood posts S:67° W 60.87'. Northeast corner of Section 3, T6N-R8W, West 30.82 feet. 107 Date 4 -30-94 ma.m Marinus A. Mulder, Chairman maris a mulch

REVISED MAY 14, 1975 REVISED JAN., 1983

FORM APPROVED BY MICHIGAN STATE BOARD OF LAND SURVEYORS, JAN. 28, 1971

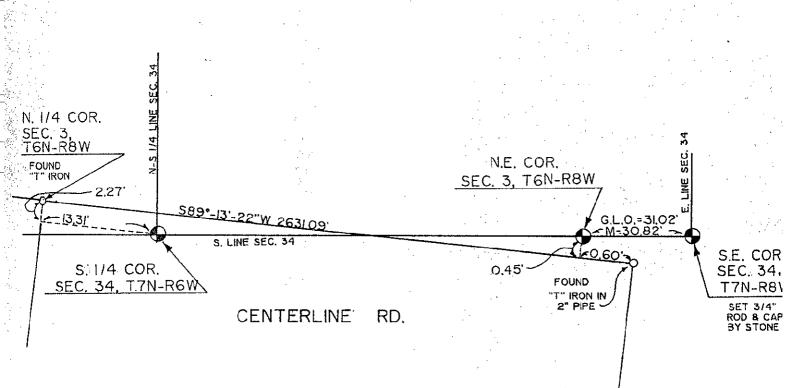

LINER 003 PAGE 123