

REMONUMENTATION CORNER
LAND CORNER RECORDATION CERTIFICATE
Filing Requirement of Act 74, Mich. P.A. 1970

For corners in

Iosco
(County)

Located in:

Corner Code #

1. Public Land Survey

T22N R7E

T21N R7E

T R

T R

1
1

2. Property Controlling
in Section

S

T R

S

T R

3. Miscellaneous
Property in Sec.

S

T R

S

T R

STATE OF MICHIGAN
IOSCO COUNTY
FILED

3 DEC 97 11:51 A.M.

RONITA M. COYLE
REGISTER OF DEEDS

97-61

Register of Deeds Stamp & File Number

4. Lot No. _____, Recorded Plat _____
5. Private Claims _____

I, James H. Granger, in a field survey on August 4, 1997 do hereby state that under requirements of P.A. 74, Michigan P.A. of 1970, the corner points mentioned in lines 1 and 2 above were in conformance with regulations and rules therefore as required in the current manual of survey instructions of the United States Department of the Interior, Bureau of Land Management or by a decree of a Court of Law and/or that the corner points mentioned in lines 3, 4 and 5 above were in conformance with the rules of the Michigan Board of Land Surveyors or by a Decree of a Court of Law, established, re-established, monumented, recovered, found as expressed below:

NOTE: Not more than 2 corners, all in the same town and range, may be recorded on this certificate.

	A	B	C	D	E	F	G	H	I	J	K	L	M
1													
2		6		5		4		3		2		1	
3													
4		7		8		9		10		11		12	
5													
6		18		17		16		15		14		13	
7													
8		19		20		21		22		23		24	
9													
10		30		29		28		27		26		25	
11													
12		31		32		33		34		35		36	
13													

A. Description of original monument and accessories and/or subsequent restoration:

Meander Post

1838 (GLO) L. Clason Set wood posts

witnesses 18" B. Oak N55°W 19LKS
11" B. Oak S55°W 19LKS
27.50 Chains E of SW Sec Cor.

1996

Richard Miller #16050 Amended Plat Ray M. Clark Sub'd

1996

Richard Miller #16050 LCRC

B. Description of corner evidence found and/or method applied in restoring or reestablishing corner:

Found 1/2" rerod and witnesses.

GLO measurement would put marker 98 ft into lake

Accept position as previously established


ACCEPTED BY THE IOSCO COUNTY
SURVEY PEER GROUP AS THE
OFFICIAL CORNER UNDER P.A.
345 OF 1990 AT A MEETING
HELD ON 9-16-97

James H. Granger

C. Description of monument for corner and accessories established to perpetuate locating the position of the corner:

Set 5/8" Rebar with Remon Cap in Mon. Box

12" Twin Ash	S 75°W	56.71'	nail & tag 16041
S. GD. Rail Post	N 80°W	101.10'	nail & tag 16041
Wood Post	N 40°W	61.34'	nail & tag 16041
12" Ash	N 20°W	42.85'	nail & tag 16041

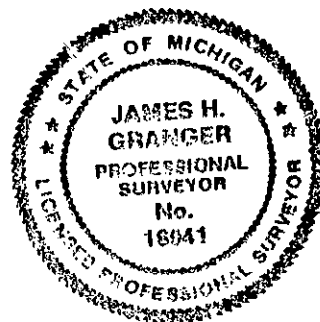

Signed by *James H. Granger*

Date Nov. 10, 1997

Surveyor's Michigan License No. 16041

SURVEY &
REMONUMENTATION

FORM APPROVED BY MICHIGAN STATE BOARD OF PROFESSIONAL SURVEYORS, JAN. 28, 1971
REVISED MAY 14, 1975

REVISED JAN., 1993
REVISED OCT., 1995

MAR 18 1998

SECTION