

SURVEY & REMONUMENTATION

MAY 07 1997

1996 IOSCO COUNTY REMONUMENTATION LAND CORNER RECORDATION CERTIFICATE Filing Requirement of Act 74, Mich. P.A. 1970

COMMISSION

For corners in

Iosco Located In: Corner Code #
(County)

1. Public Land Survey T 22N R 8E C-5
T R
T R
T R

2. Property Controlling S T R
in Section S T R

3. Miscellaneous S T R
Property in Sec. S T R

96-49

STATE OF MICHIGAN
IOSCO COUNTY
FILED

5 NOV 96 4:30 P.M.

BONITA M. COYLE
Register of Deeds Stamp & File Number

4. Lot No. , Recorded Plat

5. Private Claims

I, JAMES H. GRANGER, in a field survey on October 25, 19 96, do hereby state that under requirements of P.A. 74, Michigan P.A. of 1970, the corner points mentioned in lines 1 and 2 above were in conformance with regulations and rules therefore as required in the current manual of survey instructions of the United States Department of the Interior, Bureau of Land Management or by a decree of a Court of Law and /or that the corner points mentioned in lines 3, 4 and 5 above were in conformance with the rules of the Michigan Board of Land Surveyors or by a Decree of a Court of Law; established, re-established, monumented, recovered, found as expressed below:

NOTE: Not more than 2 corners, all in the same town and range, may be recorded on this certificate.

	A	B	C	D	E	F	G	H	I	J	K	L	M
1													
2	6		5		4		3		2		1		
3													
4	7		8		9		10		11		12		
5													
6	18		17		16		15		14		13		
7													
8	19		20		21		22		23		24		
9													
10	30		29		28		27		26		25		
11													
12	31		32		33		34		35		36		
13													

A. Description of original monument and accessories and/or subsequent restoration:

1843 GLO John Mullett Set Wood Post
6" W. Ash N 20° W 12 lks
10" B. Ash S 12° E 28 lks

ACCEPTED BY THE IOSCO COUNTY
SURVEY PEER GROUP AS THE
OFFICIAL CORNER UNDER P.A.
345 OF 1990 AT A MEETING
HELD ON 10-23-96

James H. Granger


B. Description of corner evidence found and/or method applied in restoring or reestablishing corner:

Fd rotted fence corner post at apparent corner location. Fd one rotted stump that fits GLO witness call. Long time, local resident indicated that over 70 years ago (as a youngster) he remembers a squared post where fence corner post now sits. Measurements to NE and SW Sec. corners are reasonably in agreement with GLO measurements. Accepted corner position at rotted fence corner post location. Removed post to set permanent metal marker.

C. Description of monument for corner and accessories established to perpetuate locating the position of the corner:

5/8" x 30" rebar w/Remon. Cap.

48" Maple	N 6° W	37.84'	nail & tag
8" Maple	N 85° E	67.70'	nail & tag
18" Maple	S 12° E	31.66'	nail & tag
18" Maple	N 70° W	31.65'	nail & tag

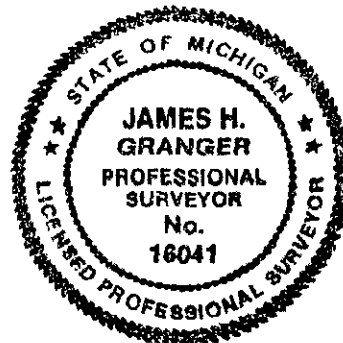

Signed by James H. Granger
Surveyor's Michigan License No. 16041

Date October 28, 1996