

SURVEY &
REMONUMENTATION

APR 27 1995
COMMISSION

IOSCO COUNTY REMONUMENTATION CORNER
LAND CORNER RECORDATION CERTIFICATE
Filing Requirement of Act 74, Mich. P.A. 1970

STATE OF MICHIGAN
IOSCO COUNTY
FILED
5 DEC 94 1:55 P.M.
BONITA H. COYLE
REGISTER OF DEEDS

For corners in
Iosco (County)
Located In: Corner Code #
1. Public Land Survey T 22N R 8E M-5 to M-6
2. Property Controlling S T R
in Section S T R
3. Miscellaneous S T R
Property in Sec. S T R
4. Lot No. , Recorded Plat
5. Private Claims

No. 4

94-24

Register of Deeds Stamp & File Number

I, James H. Granger, in a field survey on September, 1994, do hereby certify that under requirements of P.A. 74, Michigan P.A. of 1970, the corner points mentioned in lines 1 and 2 above were in conformance with regulations and rules therefore as required in the current manual of survey instructions of the United States Department of the Interior, Bureau of Land Management or by a decree of a Court of Law and/or that the corner points mentioned in lines 3, 4 and 5 above were in conformance with the rules of the Michigan Board of Land Surveyors or by a Decree of a Court of Law; established, re-established, monumented, re-monumented, recovered, found as expressed below:

NOTE: Not more than 4 corners, all in the same town and range, may be recorded on this certificate.


Table with 13 rows and 13 columns (A-M). Contains numbers 1-36 in a grid pattern.

- A. Description of original monument and accessories and/or subsequent restoration:
1837 Original Survey Set Wood Post 1963 Sub'd. Avalon Beach, Wood-lon
Lewis Clasen 8" Spruce Pine Beach & Lixey Park No. 1
N61°E 17 lks
5" Tamarack
N55°W 36 lks
1930 MDOT US-23 road plans
1931 Sub'd. Avalon Beach
1940 Sub'd. Woodland Beach

B. Description of corner evidence found and/or method applied in restoring or reestablishing corner:
Field search revealed no evidence of corner. Located corner M-5 and ex. monuments of sub'd to establish Sec. line. Extended Sec. line S. using record measurements and reestablish corner position.

ACCEPTED BY THE IOSCO COUNTY
SURVEY PEER GROUP AS THE
OFFICIAL CORNER UNDER P.A.
345 OF 1990 AT A MEETING
HELD ON 11-10-94
James H. Granger

- C. Description of monument for corner and accessories established to perpetuate locating the position of the corner:
Set 5/8" x 30" rebar with alum cap
N5°E 17.64' Set tag in 8" Birch
N20°W 38.60' Set tag in 14" Maple
S70°W 56.72' Set tag in 16" White Pine
S50°W 85.83' Set tag in 55" Willow

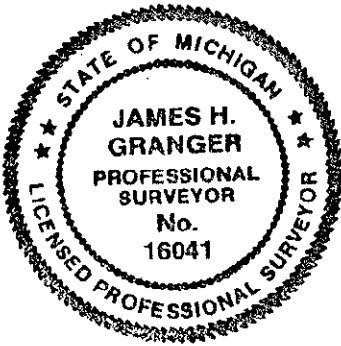

Signed by James H. Granger Date November 10, 1994
Surveyor's Michigan License No. 16041