

MAY 07 1997

COMMISSION

1996 IOSCO COUNTY REMONUMENTATION  
LAND CORNER RECORDATION CERTIFICATE  
Filing Requirement of Act 74, Mich. P.A. 1970

96-45

For corners in

Iosco  
(County)

Located In:

Corner Code #

1. Public Land Survey

T 22N R 8E

B-7 to C-7 #8

T R

T R

T R

2. Property Controlling  
in Section

S T R

S T R

3. Miscellaneous  
Property in Sec.

S T R

S T R

STATE OF MICHIGAN  
IOSCO COUNTY  
FILED

5 NOV 96 4:29 P.M.

RONITA M. COYLE  
REGISTER OF DEEDS

Register of Deeds Stamp & File Number

4. Lot No. , Recorded Plat

5. Private Claims

I, James H. Granger in a field survey on October 25, 19 96,  
do hereby certify that under requirements of P.A. 74, Michigan P.A. of 1970, the corner points mentioned  
in lines 1 and 2 above were in conformance with regulations and rules therefore as required in the  
current manual of survey instructions of the United States Department of the Interior, Bureau of Land  
Management or by a decree of a Court of Law and/or that the corner points mentioned in lines 3, 4 and 5  
above were in conformance with the rules of the Michigan Board of Land Surveyors or by a Decree of a  
Court of Law; established, re-established, monumented, re-monumented, recovered, found as  
expressed below:

NOTE: Not more than 4 corners, all in the same town and range, may be recorded  
on this certificate.

A. Description of original monument and accessories and/or subsequent restoration:

1843 GLO John Mullett Corner was 6" Black Oak  
No witnesses

B. Description of corner evidence found and/or method applied in restoring or reestablishing corner:


No original evidence found. Reestablished corner position by single proportionate  
distance on east extension of S. Sec. line from SW thru S1/4 Sec. corners.

ACCEPTED BY THE IOSCO COUNTY  
SURVEY PEER GROUP AS THE  
OFFICIAL CORNER UNDER P.A.  
345 OF 1990 AT A MEETING  
HELD ON 10-23-96

James H. Granger

C. Description of monument for corner and accessories established to perpetuate locating the position of the corner:

5/8"x30" rebar w/Remon. Cap.			
4" Popple	N 45° W	34.35'	nail & tag
8" Elm	North	21.38'	nail & tag
12" Elm	S 15° E	20.40'	nail & tag
14" Elm	S 80° W	28.20'	nail & tag

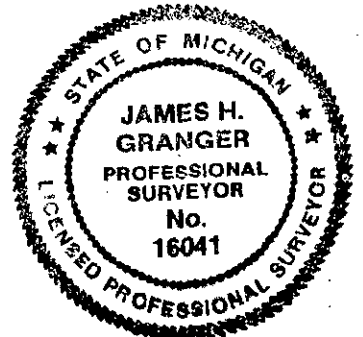

Signed by James H. Granger

Date October 28, 1996

Surveyor's Michigan License No. 16041