

SURVEY & REMONUMENTATION

APR 27 1995

COMMISSION

IOSCO COUNTY REMONUMENTATION CORNER
LAND CORNER RECORDATION CERTIFICATE
Filing Requirement of Act 74, Mich. P.A. 1970

STATE OF MICHIGAN
IOSCO COUNTY
FILED

5 DEC 94 2:01 P.M.

BONITA K. COYLE
REGISTER OF DEEDS

94-38

Register of Deeds Stamp & File Number

For corners in

IOSCO

(County)

Located In:

Corner Code ##

1. Public Land Survey

T 22N R 9E

E-1 to E-2

T R

T R

T R

T R

2. Property Controlling
in Section

S T R

S T R

3. Miscellaneous
Property in Sec.

S T R

S T R

4. Lot No. , Recorded Plat

5. Private Claims

I, John F. Oliver in a field survey on September 12, 19 94, do hereby certify that under requirements of P.A. 74, Michigan P.A. of 1970, the corner points mentioned in lines 1 and 2 above were in conformance with regulations and rules therefore as required in the current manual of survey instructions of the United States Department of the Interior, Bureau of Land Management or by a decree of a Court of Law and/or that the corner points mentioned in lines 3, 4 and 5 above were in conformance with the rules of the Michigan Board of Land Surveyors or by a Decree of a Court of Law; established, re-established, monumented, re-monumented, recovered, found as expressed below:

NOTE: Not more than 4 corners, all in the same town and range, may be recorded on this certificate.

A. Description of original monument and accessories and/or subsequent restoration:

1843 Original Survey, J.F. Munro Set Wood Post, No Trees, No Witnesses

1957 Subdivision, AuSable Point Beach No.7 (L-7, P-43-44) Meander corner falls in this plat no indication of location of corner.

B. Description of corner evidence found and/or method applied in restoring or reestablishing corner:

Set 5/8"X 30" re-rod with aluminum Cap at right angle to section line as shown on "AuSable Point Beach No.7 on southerly right-of-way of US-23.

ACCEPTED BY THE IOSCO COUNTY
SURVEY PEER GROUP AS THE
OFFICIAL CORNER UNDER P.A.
345 OF 1990 AT A MEETING
HELD ON 11-10-94

James H. Granger

C. Description of monument for corner and accessories established to perpetuate locating the position of the corner:


5/8"X 30" re-rod with aluminum cap

20" White Pine N29°E 17.62

10" Oak N53°E 8.83

Concrete Monument S66°24'W 16.30

9" White Pine S87°W 26.42

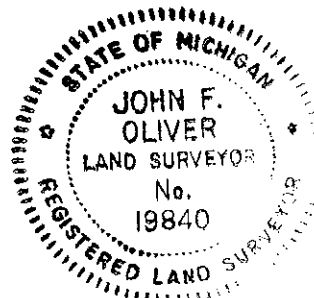

Signed by [Signature]

Date

11-11-94

Surveyor's Michigan License No. 19840