

DEC 2 2 1995

95-33

IOSCO COUNTY REMONUMENTATION  
LAND CORNER RECORDATION CERTIFICATE  
Filing Requirement of Act 74, Mich. P.A. 1970

STATE OF MICHIGAN  
IOSCO COUNTY  
FILED

For corners in

IOSCO Located In: Corner Code #  
(County)

1. Public Land Survey T 22 NR 9 E A-5 to B-5 07  
T R  
T R  
T R  
2. Property Controlling S T R  
in Section S T R  
3. Miscellaneous S T R  
Property in Sec. S T R

No. 7

12 DEC 95 2:30 P.M.

BONITA H. COYLE  
REGISTER OF DEEDS

Register of Deeds Stamp & File Number

4. Lot No. \_\_\_\_\_, Recorded Plat \_\_\_\_\_  
5. Private Claims \_\_\_\_\_

I, WILLIAM E. WOODS, in a field survey on 12-2, 1995 do hereby state that under requirements of P.A. 74, Michigan P.A. of 1970, the corner points mentioned in lines 1 and 2 above were in conformance with regulations and rules therefore as required in the current manual of survey instructions of the United States Department of the Interior, Bureau of Land Management or by a decree of a Court of Law and/or that the corner points mentioned in lines 3, 4 and 5 above were in conformance with the rules of the Michigan Board of Land Surveyors or by a Decree of a Court of Law; established, re-established, monumented, recovered, found as expressed below:

NOTE: Not more than 2 corners, all in the same town and range, may be recorded on this certificate.

	A	B	C	D	E	F	G	H	I	J	K	L	M
1													
2		6		5		4		3		2		1	
3													
4		7		8		9		10		11		12	
5													
6		18		17		16		15		14		13	
7													
8		19		20		21		22		23		24	
9													
10		30		29		28		27		26		25	
11													
12		31		32		33		34		35		36	
13													


A. Description of original monument and accessories and/or subsequent restoration:  
1843 ORIGINAL SURVEY, J.F. MUNROE SET POST 24.50 FROM RANGE LINE  
BETWEEN SECTION 7 & 8

ACCEPTED BY THE IOSCO COUNTY  
SURVEY PEER GROUP AS THE  
OFFICIAL CORNER UNDER P.A.  
345 OF 1990 AT A MEETING  
HELD ON 10-31-95

*James H. Draper*

B. Description of corner evidence found and/or method applied in restoring or reestablishing corner:  
1931 SUBDIVISION BY JOHN W. APPLIN AVALON BEACH SHOWS LINE TO BE  
20" NORTH OF LOT 1 L. 2 P. 26  
1933 SUBDIVISION BY JOHN W. APPLIN HURON HEIGHTS L. 3 P. 29

C. Description of monument for corner and accessories established to perpetuate locating the position of the corner:  
1995 REMONUMENTATION, WILLIAM E. WOODS ACCEPT POSITION AS ESTABLISHED  
BY PLATS.  
SET ALUMINUM CAP ON FOUND R.J. COOK MONUMENT.  
8" TWIN OAK S220°W 11.36  
NW CORNER HOUSE FOUNDATION 996 OTTOWAS S250°W 56.30  
16" OAK S265°W 30.26  
SE CORNER HOUSE FOUNDATION 1012 OTTOWAS N320°W 15.30

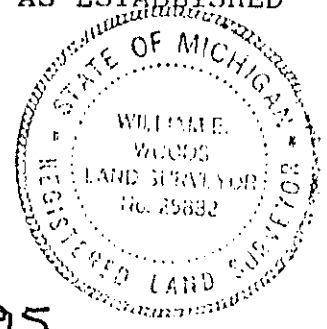

Signed by William E Woods Date 12-8-95  
Surveyor's Michigan License No. 25882