

SURVEY &
REMONUMENTATION

APR 27 1995

IOSCO COUNTY REMONUMENTATION CORNER

STATE OF MICHIGAN
IOSCO COUNTY
FILED

COMMISSION

LAND CORNER RECORDATION CERTIFICATE

Filing Requirement of Act 74, Mich. P.A. 1970

For corners in

IOSCO
(County)

Located In:

Corner Code No. 4

5 DEC 94 2:03 P.M.

BONITA M. COYLE
REGISTER OF DEEDS

94-52

Register of Deeds Stamp & File Number

1. Public Land Survey T 23N R 9E G-9 to H-9
T _____ R _____
T _____ R _____
T _____ R _____
2. Property Controlling S _____ T _____ R _____
in Section S _____ T _____ R _____
3. Miscellaneous S _____ T _____ R _____
Property in Sec. S _____ T _____ R _____
4. Lot No. _____, Recorded Plat _____
5. Private Claims _____

I, John E. Oliver in a field survey on September 13, 19 94, do hereby certify that under requirements of P.A. 74, Michigan P.A. of 1970, the corner points mentioned in lines 1 and 2 above were in conformance with regulations and rules therefore as required in the current manual of survey instructions of the United States Department of the Interior, Bureau of Land Management or by a decree of a Court of Law and/or that the corner points mentioned in lines 3, 4 and 5 above were in conformance with the rules of the Michigan Board of Land Surveyors or by a Decree of a Court of Law; established, re-established, monumented, re-monumented, recovered, found as expressed below:

NOTE: Not more than 4 corners, all in the same town and range, may be recorded on this certificate.

A. Description of original monument and accessories and/or subsequent restoration:

1844 Original Survey by William Johnston, set wood post
12" Spruce S44°W 31 links
8" Spruce N74°W 38 links

1938 Subdivision, Huron Pine Beach, indicates concrete mon at Northeast corner Lot 1, Block "A" monument not found erosion has taken out NE corner Lot 1, set corner to the west on firm ground.

B. Description of corner evidence found and/or method applied in restoring or reestablishing corner:

1994 verified position of found 1" pipe from subdivision data and set 5/8" X 30" re-bar and aluminum cap inside 1" found pipe.


ACCEPTED BY THE IOSCO COUNTY
SURVEY PEER GROUP AS THE
OFFICIAL CORNER UNDER P.A.
345 OF 1990 AT A MEETING
HELD ON 11-10-94

James H. Drayner

C. Description of monument for corner and accessories established to perpetuate locating the position of the corner:

5/8" X 30" re-bar and aluminum cap inside 1" found pipe

12" White Pine S 65°E 20.83
12" White Pine S 88°W 44.03
SE corner cabin #4 N85°E 14.85
NW corner house #3006 S73°W 19.88

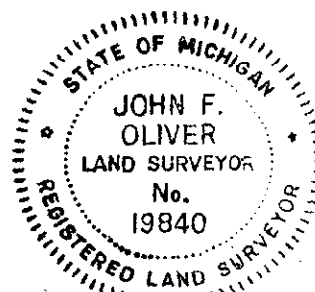

Signed by *[Signature]*
Surveyor's Michigan License No. 19840

Date 11-11-94