


LAND CORNER RECORDATION CERTIFICATE

Filing Requirement of Act 74, Mich. PA 1970

For Corners In: Iosco (County)	Located In	Corner Code #
1. Public Land Survey	T 24N R 8E	I-3
2. Property Controlling in Section	S 11 T 24N R 8E	1
3. Miscellaneous Property in Section	S T R	
4. Lot No: _____	Recorded Plat: _____	
5. Private Claims: _____		

Register of Deeds Stamp & File Number

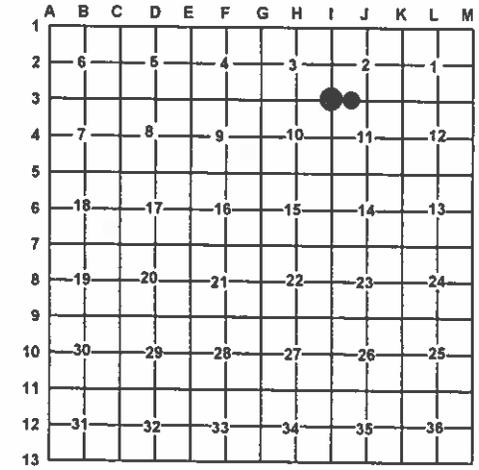

I, Carl T. Kiiskila, in a field survey on January 29, 2007 do hereby state that under requirements of PA 74, Michigan PA of 1970, the corner points mentioned in lines 1 and 2 above were in conformance with regulations and rules therefore as required in the current manual of survey instructions of the United States Department of the Interior, Bureau of Land Management or by a decree of a Court of Law and/or that the corner points mentioned in lines 3, 4 and 5 above were in conformance with the rules of the Michigan Board of Land Surveyors or by a Decree of a Court of Law; established, re-established, monumented, recovered, found as expressed below:

NOTE: Not more than 2 corners, all in the same town and range, may be recorded on this certificate.

A. Description of original monument and accessories and/or subsequent restoration:

I-3 G.L.O. J. Mullett and Wm. Burt 1843 set post for corner of sections 2,3,10, and 11.	1- William Woods P.S. #25882 set this corner doing a survey in section 2.
Wit: Spruce Pine 7" N42°E 13 links Black Oak 6" S44°E 11 links	

June 1998 William Woods P.S. #25882 found a 1/2" rod w/ P.S. cap #16041 (James Granger) for corner.
No witnesses were given.

B. Description of corner evidence found and/or method applies in restoring or re-establishing corner:

I-3 Found a 1/2" rod with a battered P.S. cap #16041 fitting William Woods surveys in sections 2 and 3.	1- Found a 1/2" rod w/ P.S. cap #25882 fitting B.L.M. instructions for the subdivision of a section.
---	--

C. Description of monument for corner and accessories established to perpetuate locating the position of the corner:

I-3 Drove a 1"x32" pipe with P.S. cap #33981 over found 1/2" bar	1- Found 1/2" rod with P.S. cap #25882
Wit: 6" Oak S15°E 28.04'	Wit: 9" Maple N18°E 11.43'
7" Oak N17°W 28.94'	10" Maple N50°W 11.73'
8" Oak S83°W 37.74'	10" Maple S19°W 16.28'
5" Oak N49°E 49.39'	7" Maple S69°E 14.57'
Blue Carsonite post South 10'±	Cedar post South 0.5'

Signed by: Carl T. Kiiskila
Surveyor's Michigan License No.: 33981

Date: 6-13-07

