

FEB 16 1999

SECTION

LAND CORNER RECORDATION CERTIFICATE

Filing Requirement of Act 74, Mich. P.A. 1970

REMONUMENTATION CORNER

For corners IOSCO

Located In: _____

Corner Code # _____

98-50

STATE OF MICHIGAN
IOSCO COUNTY
FILED

10 DEC 98 2:55 P.M.

DONITA M. COYLE
REGISTER OF DEEDS

1. Public Land Survey

T 24N R 9E 1

T _____ R _____

T _____ R _____

T _____ R _____

2. Property Controlling
in Section

S _____ T _____ R _____

S _____ T _____ R _____

3. Miscellaneous
Property in Sec.

S _____ T _____ R _____

S _____ T _____ R _____

4. Lot No. _____, Recorded Plat _____

5. Private Claims _____

I, WILLIAM E. WOODS P.S., in a field survey on NOV 17, 1998 do hereby state that under requirements of P.A. 74, Michigan P.A. of 1970, the corner points mentioned in lines 1 and 2 above were in conformance with regulations and rules therefore as required in the current manual of survey instructions of the United States Department of the Interior, Bureau of Land Management or by a decree of a Court of Law and/or that the corner points mentioned in lines 3, 4 and 5 above were in conformance with the rules of the Michigan Board of Land Surveyors or by a Decree of a Court of Law, established, re-established, monumented, recovered, found as expressed below:

NOTE: Not more than 2 corners, all in the same town and range, may be recorded on this certificate.

A. Description of original monument and accessories and/or subsequent restoration:

1843: ORIGINAL GOVERNMENT NOTES

SET POST 72.80' SOUTH OF SECTION CORNER
10" SUGAR N 35° W 23 LKS.
14" BUTTERNUT S 40° E 13 LKS.

B. Description of corner evidence found and/or method applied in restoring or reestablishing corner:

SET WITNESS CORNER 2032.74 FEET SOUTH OF 1/4 CORNER ON NORTH SIDE OF RIVER
WHICH IS 132.0 FEET NORTH OF ORIGINAL MEANDER CORNER.

ACCEPTED BY THE IOSCO COUNTY
SURVEY PEER GROUP AS THE
OFFICIAL CORNER UNDER P.A.
245 OF 1990 AT A MEETING
HELD ON 9-22-98

James H. Kranger

C. Description of monument for corner and accessories established to perpetuate locating the position of the corner

5/8 ROD WITH REMON CAP

4" ASH N 45°W 11.55

5" ASH S 30°W 7.14

3" ASH N 10° E 29.70

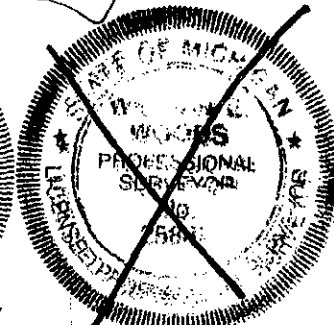
SOUTH 533.27 TO SECTION CORNER

Signed by

William E. Woods

Date

WILLIAM E. WOODS P.S.

Surveyor's Michigan License No. 25882

12-9-98