

LAND CORNER RECORDATION CERTIFICATE

Authority: 1970 PA 74, MCL 54.205

Surveyor's Name: Stephan J. Szyszkoski

Field Survey Date: September 22, 2016

For corner(s) in: Iron County

Original Public Land Survey Corner


Corner Code

S T R
S T R
S T R
S T R

Property Corner

1/16 Corner Code

a. S 8 T 41N R 32W 14 (GCDB 300520)
a. S 9 T 41N R 32W 10 (GCDB 300520)
S T R
b. S 10 T 41N R 32W H4 (GCDB 440540)

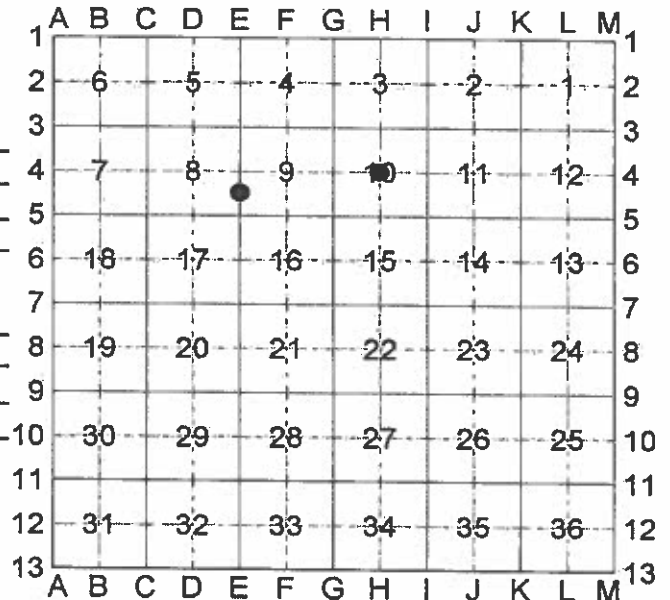

Part A. Corner History

a.) South 1/16 corner between Sections 8 and 9. 1978 - Established by A.O.Enger RLS midway and on line between Section corner 19.964 ch. S and 1/4 corner 19.964 ch. N. Set 1"IDx36" I.pipe with 3 3/4" aluminum cap. Aspen 7" N27°W 21.0'; Aspen 5" S40°W 29.1'.

b.) Center of Section 10. Not previously monumented.

Part B: Surveyor's Report on Perpetuation, Restoration, Reestablishment, or Monumentation of Corner

a.) The 1978 monument was found disturbed and approximately 4 ft. out of position under a 3' high berm. The 1978 witnesses are no longer present. Reestablished the position for the corner midway and on the Section line between Section corner 1317.33' south and Quarter corner 1317.33' north. Determined the true bearing of line E5-E4 to be N00°47'20"E.

b.) Established the position for the corner at the intersection of straight lines connecting opposite 1/4 corners.

Part C: Field Evidence of Perpetuation or Monumentation of Corner

(a.) Set 1"IDx28" I.pipe with 2" alum. MDNR cap. Set measuring nail with MDNR tag in the side of:
9" Balsam S65°W 19.4' mrkd "1/16S BT"
7" Balsam N78°W 23.8' do
4" twin Balsam N51°W 26.95' do
OHVPP (metal) #116757 N60°E 34.0' to face.
E= 7897258.728 N= 131705.226

(b.) Set 1"IDx28" I.pipe with 2" alum. MDNR cap. Set measuring nail with MDNR tag in the side of:
3" Oak N87°E 11.2' mrkd "C1/4 BT"
7" Maple in clump S72°E 13.1' do
5" Maple S66°W 18.25' do
7" Maple N86°W 14.6' do
Set sq'd cedar post adjacent.
E= 7899696.259 N= 132057.045

Bearings are magnetic. Coordinates are MCS83, NAD83(2011) Epoch 2010.00, in meters
Coordinate Reference: NGS PID AA8081, E= 7895147.466 m. N= 147176.690 m.

Stephan J. Szyszkoski

11/22/2016

Professional Surveyor's License No.: 33986

page 1 of 1

Prepared By: S.J. Szyszkoski for the Michigan Dept. of Natural Resources, 427 N. US41 Baraga, MI 49908

