

SURVEY &
REMONUMENTATION

FORM NO. 985-A



Stock No. 26273

MAR 19 1997

COMMISSION

LAND CORNER RECORDATION CERTIFICATE
Filing Requirement of Act 74, Mich. P.A. 1970

For corners in

Iron
(County)

Located In:

Corner Code #

1. Public Land Survey

T 42N R 33W

B.C-11 (002)

T R

T R

T R

T R

2. Property Controlling
in Section

S T R

S T R

3. Miscellaneous
Property in Sec.

S T R

S T R

IRON COUNTY
MICHIGAN
RECEIVED FOR RECORD

96 DEC 23 AM 9:05

L.C. Records L. 7, P. 52

Gary L. Pisoni

REGISTERED LAND SURVEYOR

Register of Deeds Stamp & File Number

4. Lot No. , Recorded Plat

5. Private Claims

Meander Corner between Sections 30 & 31, T42N R33W

I, Gary L. Pisoni, in a field survey on November 11, 1996 do hereby state that under requirements of P.A. 74, Michigan P.A. of 1970, the corner points mentioned in lines 1 and 2 above were in conformance with regulations and rules therefore as required in the current manual of survey instructions of the United States Department of the Interior, Bureau of Land Management or by a decree of a Court of Law and/or that the corner points mentioned in lines 3, 4 and 5 above were in conformance with the rules of the Michigan Board of Land Surveyors or by a Decree of a Court of Law; established, re-established, monumented, recovered, found as expressed below:

NOTE: Not more than 2 corners, all in the same town and range, may be recorded on this certificate.

	A	B	C	D	E	F	G	H	I	J	K	L	M
1													
2	6		5		4		3		2		1		
3													
4	7		8		9		10		11		12		
5													
6	18		17		16		15		14		13		
7													
8	19		20		21		22		23		24		
9													
10	30		29		28		27		26		25		
11													
12	31		32		33		34		35		36		
13													

A. Description of original monument and accessories and/or subsequent restoration:

Original corner established by Guy H. Carleton, U.S. Deputy Surveyor in October, 1851.

Original corner: Wood Post

Original bearing trees:

Cedar	10"	S 65° W	12 links (7.92 feet)
Cedar	8"	N 10° W	14 links (9.24 feet)

B. Description of corner evidence found and/or method applied in restoring or reestablishing corner:

No original corner evidence found.

In 1973, Donald D. Lappala RLS recovered the GLO B.T.s to the meander corner and set a wood post marking corner position.

In 1994, I found wood post lying on ground and replaced wood post with a 5/8"x30" rebar pin.

I accepted the wood post as the best available evidence for restoring corner position.

Meander corner is 18 feet from West bank of Brule River.

Corner Record Research on file with County Representative.


PEER GROUP APPROVED

Gary L. Pisoni 12-11-96
COUNTY REPRESENTATIVE

C. Description of monument for corner and accessories established to perpetuate locating the position of the corner:

Replaced rebar pin with a 3/4" outside diameter by 3 feet long aluminum rod monument with a 3" cast aluminum cap, stamped to read: Iron County Remonumentation, T42N, R33W, S-30, S-31, M.C., 1996, RLS-27457 from which I established the following new blazed and scribed bearing trees: (all measurements taken to a nail in side of tree)

Cedar	7"	N 19° E	30.97 feet
Cedar (Existing)	7"	S 22° W	23.67 feet
Cedar	8"	S 79° W	62.86 feet
White Spruce	11"	N 49° W	16.17 feet
Snow fence stake		East	0.50 feet
Steel Sign Post	6'	West	0.71 feet

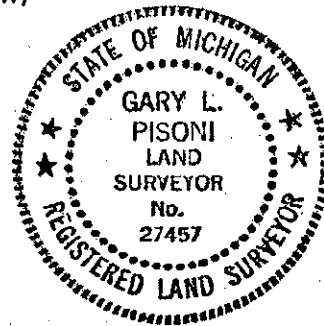

#96-30

Signed by *Gary L. Pisoni*

Date 12-10-96

Surveyor's Michigan License No. 27457

FORM APPROVED BY MICHIGAN STATE BOARD OF PROFESSIONAL SURVEYORS, JAN. 28, 1971
REVISED MAY 14, 1975
REVISED JAN., 1983
REVISED OCT., 1995

L. 7 P. 52