

# SURVEY & REMONUMENTATION

FORM NO. 985-A



Stock No. 26273

MAR 19 1997

## COMMISSION

### LAND CORNER RECORDATION CERTIFICATE Filing Requirement of Act 74, Mich. P.A. 1970

For corners in

Iron  
(County)

Located In:

Corner Code #

1. Public Land Survey

T. 42N R. 33W

H.I-7b(0121)

2. Property Controlling  
in Section

S.      T.      R.     

3. Miscellaneous  
Property in Sec.

S.      T.      R.     

4. Lot No.         , Recorded Plat         

5. Private Claims         

East Witness Corner Meander Corner between Sections 15 & 22, T42N R33W

I, Gary L. Pisoni, in a field survey on November 22, 1996 do hereby state that under requirements of P.A. 74, Michigan P.A. of 1970, the corner points mentioned in lines 1 and 2 above were in conformance with regulations and rules therefore as required in the current manual of survey instructions of the United States Department of the Interior, Bureau of Land Management or by a decree of a Court of Law and for that the corner points mentioned in lines 3, 4 and 5 above were in conformance with the rules of the Michigan Board of Land Surveyors or by a Decree of a Court of Law; established, re-established, monumented, recovered, found as expressed below:

**NOTE:** Not more than 2 corners, all in the same town and range, may be recorded on this certificate.

A. Description of original monument and accessories and/or subsequent restoration:

Original corner established by Guy H. Carleton, U.S. Deputy Surveyor in 1851.

Original corner: Wood Post

Original bearing trees:

Hemlock	10"	N 37° E	09 links ( 5.94 feet)
Hemlock	18"	S 15° E	28 links (18.48 feet)
Small Island		N 75° W	

B. Description of corner evidence found and/or method applied in restoring or reestablishing corner:

No original corner evidence found.

In 1978, Donald D. Lappala, R.L.S., set roof bolt.

Found said roof bolt, 9 feet from waters edge on North edge of boat access road ramp to Buck Lake.

Accepted roof bolt as the best available evidence for restoring meander corner position. Set 3/4" outside dia. By 3 feet long aluminum rod monument with 3" cast aluminum cap as a Witness Corner to roof bolt as Meander Corner, stamped to read: Iron County Remonumentation, T42N, R33W, W.C., M.C., S-15, S-22, 10.00', N 88°42.7' W, 1996, RLS - 27457.

Corner Record Research on file with County Representative.

C. Description of monument for corner and accessories established to perpetuate locating the position of the corner:

From the above described roof bolt, blazed and scribed the following new blazed and scribed bearing trees: (all measurements taken to a nail in side of tree)

White Birch	6"	N 47° E	13.34 feet
W.C.	3/4" x 3' Aluminum		
M.C.	Rod with Cap	S 88° 42.7' E	10.00 feet
Red Maple	12" Dbl.	S 10° W	108.47 feet
Small Island		N 75° W	
Steel Sign Post	6'	S 88° 42.7' E	10.65 feet

#96-71

Signed by Gary L. Pisoni

Date 12-10-96

Surveyor's Michigan License No. 27457

FORM APPROVED BY MICHIGAN STATE BOARD OF PROFESSIONAL SURVEYORS, JAN. 28, 1971  
REVISED MAY 14, 1975  
REVISED JAN., 1983  
REVISED OCT., 1995

IRON COUNTY  
MICHIGAN  
RECEIVED FOR RECORD


96 DEC 23 AM 9: 21

L.C. Records L. 7, P. 93  
Gailen Stiles  
REGISTER OF DEEDS

Register of Deeds Stamp & File Number

A	B	C	D	E	F	G	H	I	J	K	L	M
1												
2	6		5		4		3		2		1	
3												
4	7		8		9		10		11		12	
5												
6	18		17		16		15		14		13	
7												
8	19		20		21		22		23		24	
9												
10	30		29		28		27		26		25	
11												
12	31		32		33		34		35		36	
13												

PEER GROUP APPROVED  
Iron Gary L. Pisoni 12-11-96  
COUNTY REPRESENTATIVE

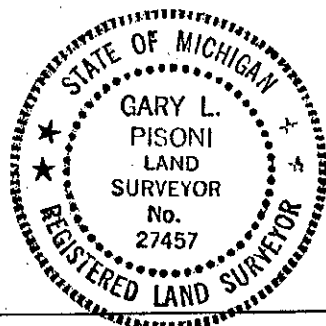

L. 7 P. 93