

RE

MAR 9 2000

SECTION

LAND CORNER RECORDATION CERTIFICATE
Filing Requirement of Act 74, Mich. P.A. 1970

For corners in

Iron
(County)

Located In:

Corner Code #

1. Public Land Survey

T 42N R 33W

A-12.13 (013) ✓

T 42N R 34W

M-12.13 (001)

T R

T R

2. Property Controlling
in Section

S T R

S T R

3. Miscellaneous

S T R

Property in Sec.

S T R

IRON COUNTY
MICHIGAN
RECEIVED FOR RECORD

99 DEC 30 AM 10:31

L.C. Records: L. 8, P. 120

Robert L. Pisoni
REGISTERED LAND SURVEYOR

Register of Deeds Stamp & File Number

4. Lot No. _____, Recorded Plat _____

5. Private Claims _____

Witness Corner

Meander Corner between S.36, T42N R34W & S.31, T42N R33W

I, Gary L. Pisoni, in a field survey on December 4, 1996 do hereby state that under requirements of P.A. 74, Michigan P.A. of 1970, the corner points mentioned in lines 1 and 2 above were in conformance with regulations and rules therefore as required in the current manual of survey instructions of the United States Department of the Interior, Bureau of Land Management or by a decree of a Court of Law and/or that the corner points mentioned in lines 3, 4 and 5 above were in conformance with the rules of the Michigan Board of Land Surveyors or by a Decree of a Court of Law; established, re-established, monumented, recovered, found as expressed below:

NOTE: Not more than 2 corners, all in the same town and range, may be recorded on this certificate.

	A	B	C	D	E	F	G	H	I	J	K	L	M
1													
2		6		5		4		3		2		1	
3													
4		7		8		9		10		11		12	
5													
6		18		17		16		15		14		13	
7													
8		19		20		21		22		23		24	
9													
10		30		29		28		27		26		25	
11													
12		31		32		33		34		35		36	
13													

A. Description of original monument and accessories and/or subsequent restoration:

Original corner established by Austin Burt, U.S. Deputy Surveyor on September 8, 1846.

Original corner: 12" Cedar Meander Corner Tree

Original bearing tree:

Cedar 14" N 53° E 14 links (9.24 feet)

PEER GROUP APPROVED

Don Ray L. Pisoni 12-31-99

COUNTY REPRESENTATIVE

B. Description of corner evidence found and/or method applied in restoring or reestablishing corner:

No original corner evidence found.

Set Witness Corner Meander Corner by extending Range line from the W 1/4 corner of Section 30 thru the Southwest corner of Section 30 to the North bank of the Brule River.

I accept this solution as the best available evidence for restoring the corner position.


Monument is 13 feet from waters edge.

Corner Record Research on file with County Representative.

C. Description of monument for corner and accessories established to perpetuate locating the position of the corner:

At the corner position, I set a 5/8" outside diameter by 30" long rebar pin with a 3" cast aluminum cap, stamped to read: Iron County Remonumentation, T42N, R34W, R33W, S-36, S-31, W.C., M.C., 1996, RLS-27457 from which I established the following new blazed and scribed bearing trees: (all measurements taken to a nail in side of tree)

Ash	8" DbL.	N 06° E	17.33 feet
Ash	10"	N 40° E	23.50 feet
Ash	12" DbL.	East	17.50 feet
Ash	14"	S 37° E	15.78 feet
Steel Sign Post	6'	S 81° W	0.80 feet

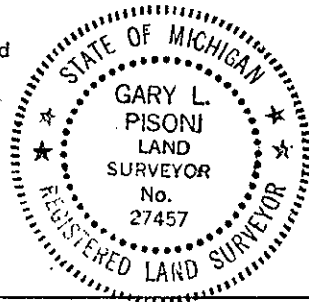

99-120

Signed by *Ray L. Pisoni*Date *12-28-99*Surveyor's Michigan License No. 27457

FORM APPROVED BY MICHIGAN STATE BOARD OF PROFESSIONAL SURVEYORS, JAN. 28, 1971
REVISED MAY 14, 1975
REVISED JAN., 1983
REVISED OCT., 1995

LIBER

8 PAGE 120