

# SURVEY & REMONUMENTATION

JAN 19 1999

## SECTION

### LAND CORNER RECORDATION CERTIFICATE Filing Requirement of Act 74, Mich. P.A. 1970

For corners in

<u>Iron</u>	Located In:	Corner Code #
(County)		
1. Public Land Survey	T <u>42N</u> R <u>33W</u>	<u>1-6, 7n</u>
	T <u>    </u> R <u>    </u>	<u># 014</u>
	T <u>    </u> R <u>    </u>	
	T <u>    </u> R <u>    </u>	
2. Property Controlling	S <u>    </u> T <u>    </u> R <u>    </u>	
in Section	S <u>    </u> T <u>    </u> R <u>    </u>	
3. Miscellaneous	S <u>    </u> T <u>    </u> R <u>    </u>	
Property in Sec.	S <u>    </u> T <u>    </u> R <u>    </u>	

IRON COUNTY  
MICHIGAN  
RECEIVED FOR RECORD

98 DEC 28 AM 11:25  
L.C. Records: L. 7, P. 318  
*Robert L. Pisoni*

Register of Deeds Stamp & File Number

4. Lot No.         , Recorded Plat           
5. Private Claims         

North Meander Corner Sections 14 and 15, T42N, R33W

I, Gary L. Pisoni, in a field survey on Dec. 7, 1998 do hereby state that under requirements of P.A. 74, Michigan P.A. of 1970, the corner points mentioned in lines 1 and 2 above were in conformance with regulations and rules therefore as required in the current manual of survey instructions of the United States Department of the Interior, Bureau of Land Management or by a decree of a Court of Law and /or that the corner points mentioned in lines 3, 4 and 5 above were in conformance with the rules of the Michigan Board of Land Surveyors or by a Decree of a Court of Law; established, re-established, monumented, recovered, found as expressed below:

	A	B	C	D	E	F	G	H	I	J	K	L	M
1													
2	6			5		4		3		2		1	
3													
4	7			8		9		10		11		12	
5													
6	18			17		16		15		14		13	
7													
8	19			20		21		22		23		24	
9													
10	30			29		28		27		26		25	
11													
12	31			32		33		34		35		36	
13													

NOTE: Not more than 2 corners, all in the same town and range, may be recorded on this certificate.

#### A. Description of original monument and accessories and/or subsequent restoration:

Original corner established in October, 1851 by Guy H. Carleton, U.S. Deputy Surveyor.

Original Corner: Wood Post

Original Bearing Trees:

Yellow Pine	9"	N 80° E	8 lks. (5.28 feet)
Yellow Pine	16"	N 70° W	64 lks. (42.24 feet)

PEER GROUP APPROVED

*Gary L. Pisoni 12-18-98*  
COUNTY REPRESENTATIVE

#### B. Description of corner evidence found and/or method applied in restoring or reestablishing corner:

No evidence of original B.T.s found. Meander Corner is a 5" diameter concrete monument located in a Resort and 15 feet from waters edge. Corner is part of the Rysberg's Plat of Buck Lake which was surveyed by George A. Kopler RLS in 1962.

I accept the plat concrete monument as the best available evidence for restoring the corner position.

Corner record research on file with County Representative.

#### C. Description of monument for corner and accessories established to perpetuate locating the position of the corner:

From the above described corner position, I established the following reference objects: (no scribing or signs on bearing trees, all measurements taken to a nail in side of tree)

NW corner of boat house	N 77° E	13.81 feet
Red Maple	10" triple S 43° W	7.26 feet
Red Pine	12" N 43° W	20.10 feet

98-59

Signed by

*Gary L. Pisoni*


Date

12-21-98

Surveyor's Michigan License No.

27457

FORM APPROVED BY MICHIGAN STATE BOARD OF PROFESSIONAL SURVEYORS JAN. 28, 1971  
REVISED MAY 14, 1975  
REVISED JAN., 1983  
REVISED OCT., 1995

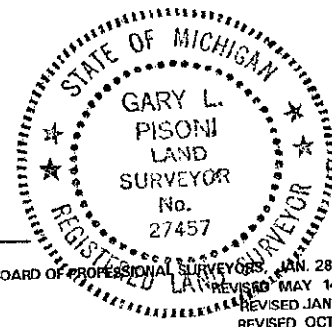

L. 7 P. 318