

# SURVEY & REMONUMENTATION

JAN 19 1999

## SECTION

### LAND CORNER RECORDATION CERTIFICATE Filing Requirement of Act 74, Mich. P.A. 1970

For corners in

<u>Iron</u> (County)	Located In:	Corner Code #
1. Public Land Survey	T <u>42N</u> R <u>33W</u>	<u>A-4.5 #016</u> ✓
	T <u>42N</u> R <u>34W</u>	<u>M-4.5 #002</u>
	T _____ R _____	_____
	T _____ R _____	_____
2. Property Controlling in Section	S _____ T _____ R _____	_____
	S _____ T _____ R _____	_____
3. Miscellaneous Property in Sec.	S _____ T _____ R _____	_____
	S _____ T _____ R _____	_____

IRON COUNTY  
MICHIGAN  
RECEIVED FOR RECORD

98 DEC 28 AM 11:30

L.C. Records: L.T.P. 340

*Richard L. Pisoni*  
1998

Register of Deeds Stamp & File Number

4. Lot No. \_\_\_\_\_, Recorded Plat \_\_\_\_\_  
5. Private Claims \_\_\_\_\_

North Meander Corner Section 7, T42N, R33W  
North Meander Corner Section 12, T42N, R34W

I, Gary L. Pisoni, in a field survey on Nov. 5, 1998 do hereby state that under requirements of P.A. 74, Michigan P.A. of 1970, the corner points mentioned in lines 1 and 2 above were in conformance with regulations and rules therefore as required in the current manual of survey instructions of the United States Department of the Interior, Bureau of Land Management or by a decree of a Court of Law and /or that the corner points mentioned in lines 3, 4 and 5 above were in conformance with the rules of the Michigan Board of Land Surveyors or by a Decree of a Court of Law; established, re-established, monumented, recovered, found as expressed below:

NOTE: Not more than 2 corners, all in the same town and range, may be recorded on this certificate.

1	A	B	C	D	E	F	G	H	I	J	K	L	M
2		6		5		4		3		2		1	
3													
4		7		8		9		10		11		12	
5													
6		18		17		16		15		14		13	
7													
8		19		20		21		22		23		24	
9													
10		30		29		28		27		26		25	
11													
12		31		32		33		34		35		36	
13													

A. Description of original monument and accessories and/or subsequent restoration:

Original corner established on September 8, 1846 by Austin Burt, U.S. Deputy Surveyor.

Original Corner; Aspen 8" Meander Corner

Original Bearing Trees:

Aspen 8" N 45° W 3 links (1.98 feet)

PEER GROUP APPROVED  
Iron Co. Representative 12-18-98  
COUNTY REPRESENTATIVE

B. Description of corner evidence found and/or method applied in restoring or reestablishing corner:

No evidence of original B.T.s found. Found an iron pin located on the North shore of Indian Lake. GLO distance from the quarter corner to the Meander corner is 1541.1 feet. The measured distance from the quarter corner to the Meander corner is 1535.28 feet.

I accept the iron pin as the best available evidence for restoring the corner position.

Iron pin is 20' from waters edge.

Corner record research on file with County Representative.

C. Description of monument for corner and accessories established to perpetuate locating the position of the corner:

At the corner position, set a 3" diameter aluminum cap over the top of the existing iron pin and stamped as follows:  
Iron County Remonumentation, T42N, R34W, R33W, M.C., S-12, S-7, 1998, RLS 27457 from which I established the following new blazed and scribed bearing trees: (All measurements taken to a nail in side of tree)

White Pine	30"	S 75°W	3.22 feet
Sugar Maple	6"	N 63°W	22.56 feet
Hemlock	10"	N 02°W	23.34 feet
Oak	7"	N 80°E	37.20 feet
Steel sign post		N 87°E	0.80 feet

98-169

Signed by Gary L. Pisoni

Date 12-21-98


Surveyor's Michigan License No. 27457

FORM APPROVED BY MICHIGAN STATE BOARD OF PROFESSIONAL SURVEYORS JAN 28 1971

REVISED MAY 24 1975

REVISED JAN. 1983

REVISED OCT. 1995

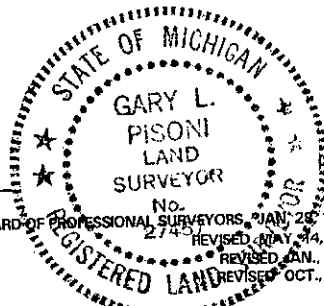

L.T.P. 340