

RF

MAR 09 2000

## SECTION

LAND CORNER RECORDATION CERTIFICATE  
Filing Requirement of Act 74, Mich. P.A. 1970

For corners in

|                                       | <u>Iron</u><br>(County) | Located In:                 | Corner Code #     |
|---------------------------------------|-------------------------|-----------------------------|-------------------|
| 1. Public Land Survey                 |                         | T <u>42N</u> R <u>34W</u>   | <u>K-4,5(008)</u> |
|                                       |                         | T <u>    </u> R <u>    </u> | <u>    </u>       |
|                                       |                         | T <u>    </u> R <u>    </u> | <u>    </u>       |
|                                       |                         | T <u>    </u> R <u>    </u> | <u>    </u>       |
| 2. Property Controlling<br>in Section | S <u>    </u>           | T <u>    </u> R <u>    </u> | <u>    </u>       |
|                                       | S <u>    </u>           | T <u>    </u> R <u>    </u> | <u>    </u>       |
| 3. Miscellaneous<br>Property in Sec.  | S <u>    </u>           | T <u>    </u> R <u>    </u> | <u>    </u>       |
|                                       | S <u>    </u>           | T <u>    </u> R <u>    </u> | <u>    </u>       |

IRON COUNTY  
MICHIGAN  
RECEIVED FOR RECORD

99 DEC 30 AM 10:34

L.C. Records: L. 8, P. 135

*Richard J. Pisoni*  
REGISTERED LAND SURVEYOR

Register of Deeds Stamp &amp; File Number

4. Lot No.         , Recorded Plat           
5. Private Claims         

South Meander Corner to Sections 11 and 12, T42N, R34W

I, Gary L. Pisoni, in a field survey on Nov. 20, 1999 do hereby state that under requirements of P.A. 74, Michigan P.A. of 1970, the corner points mentioned in lines 1 and 2 above were in conformance with regulations and rules therefore as required in the current manual of survey instructions of the United States Department of the Interior, Bureau of Land Management or by a decree of a Court of Law and/or that the corner points mentioned in lines 3, 4 and 5 above were in conformance with the rules of the Michigan Board of Land Surveyors or by a Decree of a Court of Law; established, re-established, monumented, recovered, found as expressed below:

NOTE: Not more than 2 corners, all in the same town and range, may be recorded on this certificate.

|    | A | B  | C | D  | E | F  | G | H  | I | J  | K | L  | M |
|----|---|----|---|----|---|----|---|----|---|----|---|----|---|
| 1  |   |    |   |    |   |    |   |    |   |    |   |    |   |
| 2  |   | 6  |   | 5  |   | 4  |   | 3  |   | 2  |   | 1  |   |
| 3  |   |    |   |    |   |    |   |    |   |    |   |    |   |
| 4  |   | 7  |   | 8  |   | 9  |   | 10 |   | 11 |   | 12 |   |
| 5  |   |    |   |    |   |    |   |    |   |    |   |    |   |
| 6  |   | 18 |   | 17 |   | 16 |   | 15 |   | 14 |   | 13 |   |
| 7  |   |    |   |    |   |    |   |    |   |    |   |    |   |
| 8  |   | 19 |   | 20 |   | 21 |   | 22 |   | 23 |   | 24 |   |
| 9  |   |    |   |    |   |    |   |    |   |    |   |    |   |
| 10 |   | 30 |   | 29 |   | 28 |   | 27 |   | 26 |   | 25 |   |
| 11 |   |    |   |    |   |    |   |    |   |    |   |    |   |
| 12 |   | 31 |   | 32 |   | 33 |   | 34 |   | 35 |   | 36 |   |
| 13 |   |    |   |    |   |    |   |    |   |    |   |    |   |

## A. Description of original monument and accessories and/or subsequent restoration:

Original corner established on October 7, 1851 by Guy H. Carleton, U.S. Deputy Surveyor.

Original Corner; Wood Post

Original Bearing Trees:

|         |     |         |                     |
|---------|-----|---------|---------------------|
| Hemlock | 16" | N 27° W | 28 lks (18.48 feet) |
| Cedar   | 8"  | N 37° E | 30 lks (19.80 feet) |

PEER GROUP APPROVED

*Iron County L. Pisoni 12-21-99*

COUNTY REPRESENTATIVE

## B. Description of corner evidence found and/or method applied in restoring or reestablishing corner:

No evidence of original B.T.s found.

Found a 1/2" diameter x 12" rebar with an plastic survey cap set by Carl Johnson RLS 30083 located on an old wire fence line running North between Sections 11 and 12, said rebar is 2' from waters edge.


I accept the rebar pin as the best available evidence for restoring the corner position.

Corner record research on file with County Representative.

## C. Description of monument for corner and accessories established to perpetuate locating the position of the corner:

At the corner position, I replaced the 1/2" rebar with a 5/8" diameter by 30" long rebar with a 3" diameter aluminum cap stamped as follows: Iron County Remonumentation, T42N, R34W, M.C., S-11, S-12, 1999, RLS 27457 from which I established the following new blazed and scribed bearing trees: (All measurements taken to a nail in side of tree)

|                 |           |         |            |
|-----------------|-----------|---------|------------|
| Rebar           | 5/8" dia. | S 78° W | 0.11 feet  |
| Red Maple       | 6"        | N 79° W | 49.28 feet |
| Red Maple       | 8"        | N 49° W | 24.32 feet |
| Hemlock         | 12"       | N 34° E | 10.13 feet |
| Cedar           | 6"        | N 67° E | 46.83 feet |
| Steel sign post |           | North   | 0.70 feet  |

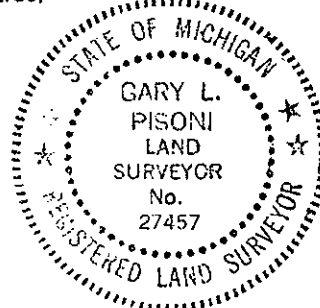

99-135

Signed by

*Gary L. Pisoni*

Date

12-28-99

Surveyor's Michigan License No. 27457

FORM APPROVED BY MICHIGAN STATE BOARD OF PROFESSIONAL SURVEYORS, JAN. 28, 1971

REVISED MAY 14, 1975

REVISED JAN., 1983

REVISED OCT., 1995