

RECEIVED

MAR 9 2000

## SECTION

## LAND CORNER RECORDATION CERTIFICATE

Filing Requirement of Act 74, Mich. P.A. 1970

For corners in

	Iron (County)	Located In:	Corner Code #
1. Public Land Survey		T. 43N R. 32W	G-9.10
		T. R.	(005)
		T. R.	
		T. R.	
2. Property Controlling in Section	S. T. R.		
	S. T. R.		
3. Miscellaneous Property in Sec.	S. T. R.		
	S. T. R.		

IRON COUNTY  
MICHIGAN  
RECEIVED FOR RECORD

99 DEC 30 AM 10:23

L.C. Records: L.S., P. 81

*Richard J. Pisoni*  
REGISTERED LAND SURVEYOR

Register of Deeds Stamp & File Number

4. Lot No. \_\_\_\_\_, Recorded Plat \_\_\_\_\_  
5. Private Claims \_\_\_\_\_

South Meander Corner to Sections 28 and 27, T43N, R32W

I, Gary L. Pisoni, in a field survey on Dec. 18, 1999, do hereby state that under requirements of P.A. 74, Michigan P.A. of 1970, the corner points mentioned in lines 1 and 2 above were in conformance with regulations and rules therefore as required in the current manual of survey instructions of the United States Department of the Interior, Bureau of Land Management or by a decree of a Court of Law and /or that the corner points mentioned in lines 3, 4 and 5 above were in conformance with the rules of the Michigan Board of Land Surveyors or by a Decree of a Court of Law; established, re-established, monumented, recovered, found as expressed below:

NOTE: Not more than 2 corners, all in the same town and range, may be recorded on this certificate.

	A	B	C	D	E	F	G	H	I	J	K	L	M
1													
2	6			5		4		3		2		1	
3													
4	7			8		9		10		11		12	
5													
6	18			17		16		15		14		13	
7													
8	19			20		21		22		23		24	
9													
10	30			29		28		27		26		25	
11													
12	31			32		33		34		35		36	
13													

### A. Description of original monument and accessories and/or subsequent restoration:

Original corner established on August 25, 1849 by Z. B. Searls, U.S. Deputy Surveyor.

Original Corner; 12" Aspen Meander Corner Post

Original Bearing Trees:

Maple 6" S 14° E 12 lks (7.92 feet)

In 1974, Donald D. Lappala RLS, established a Meander corner on the South shore of Runkle Lake. He set a 4" x 4" x 36" long concrete monument 20' from waters edge, said concrete monument is also known as the Northwest corner of the Plat of Runkle Lake.

No bearing trees established.

PEER GROUP APPROVED

*Iron Aug. 2, 1999*

COUNTY REPRESENTATIVE

### B. Description of corner evidence found and/or method applied in restoring or reestablishing corner:

No evidence of original B.T.s found.

Found the above described monument located on a North/South fence line and is 32 feet from waters edge and 20 feet from the high water mark.

I accept the concrete monument as the best available evidence for restoring the corner position.

Corner record research on file with County Representative.

### C. Description of monument for corner and accessories established to perpetuate locating the position of the corner:

Set one (1) reference monument, being a 5/8" diameter by 30" long rebar pin with a 3" diameter aluminum cap stamped as follows: Iron County Remonumentation, T43N, R32W, R.M., M.C., S-28, S-27, West, 4.65 feet, 1999, RLS 27457, of which


I established the following new bearing trees: (All measurements taken to a nail in side of tree)

R.M.	5/8" x 30" rebar	East	4.65 feet
Red Pine	13"	S 23° E	15.82 feet
Red Pine	16"	S 10° W	16.12 feet
Red Maple	20"	N 47° W	16.56 feet
Steel sign post		N 52° E	0.85 feet

99-81

Signed by Gary L. Pisoni Date 12-28-99

Surveyor's Michigan License No. 27457

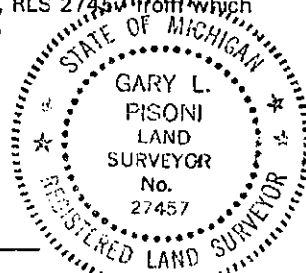

FORM APPROVED BY MICHIGAN STATE BOARD OF PROFESSIONAL SURVEYORS, JAN. 28, 1971  
REVISED MAY 14, 1975  
REVISED JAN., 1993  
REVISED OCT., 1995