

SURVEY &
REMONUMENTATION

APR 27 1995

COMMISSION

LAND CORNER RECORDATION CERTIFICATE
Filing Requirement of Act 74, Mich. P.A. 1970

For corners in
IRON

(County)

Located in:

Corner Code #

1. Public Land Survey

T 43N R 33W

A/B-13 (#002)

T 42N R 33W

A/B-1

2. Property Controlling
in Section

S T R

S T R

3. Miscellaneous

S T R

Property in Sec.

S T R

4. Lot No. , Recorded Plat

5. Private Claims

IRON COUNTY
MICHIGAN
RECEIVED FOR RECORD

95 FEB 10 PM 3:27
L.C. RECORDS L.6 P.348

Spencer Stiles
REGISTER OF DEEDS

Register of Deeds Stamp & File Number

I, Alan K. Pierce

December

19 94

do hereby certify that under requirements of P.A. 74, Michigan P.A. of 1970, the corner points mentioned in lines 1 and 2 above were in conformance with regulations and rules therefore as required in the current manual of survey instructions of the United States Department of the Interior, Bureau of Land Management or by a decree of a Court of Law and/or that the corner points mentioned in lines 3, 4 and 5 above were in conformance with the rules of the Michigan Board of Land Surveyors or by a Decree of a Court of Law; established, re-established, monumented, re-monumented, recovered, found as expressed below:

NOTE: Not more than 4 corners, all in the same town and range, may be recorded on this certificate.

A. Description of original monument and accessories and/or subsequent restoration:

A/B-1/13: Meander Corner on the East side of Lake Chicagon between Sections 6 and 31, T42/43N, R33W.

1846: Austin Burt set a White Birch meander post during establishment of Township Line T42/43N and established the following witnesses: 6" Aspen S28°E, 20L; 6" White Birch N73°E, 6L.

B. Description of corner evidence found and/or method applied in restoring or reestablishing corner:

A/B-1/13; 1994, ECI: No verifiable original evidence recovered. The following measurements were noted from B-1/13 to G.L.O. terrain calls: "Descend Hill - W", 33' G.L.O. - 32' ECI; "Intersect Lake - W", 346' G.L.O. - 349' ECI. Record corner distance is in an exposed position on lakeshore. Witness Corner to Meander Corner position established about 13' E of lakeshore on an extension of the line from C-1/13 through B-1/13. Adjacent property descriptions to South and North were felt to be inconclusive in fixing corner placement. North descriptions all show different E-W property line bearings per survey plat recorded in Liber 231, Page 410. Set Iron County Remonumentation monument, a 2" diameter x 30" long aluminum pipe with 3" diameter aluminum cap stamped to identify the corner at grade and established witnesses. Distance West to water's edge 13', distance East to B-1/13 336.00'.

PEER GROUP APPROVED

Alan K. Pierce
COUNTY REPRESENTATIVE

A.P. 1-25-95

C. Description of monument for corner and accessories established to perpetuate locating the position of the corner:

Bearing trees are face, nail, and butt blazed and painted yellow unless noted otherwise. Distances are measured from a 16d double head nail with an orange plastic washer stamped "ECI - 30097" in the side of the bearing tree. Face blaze is scribed with an "X". Butt blaze is scribed "BT". Metal sign/tag placed above face blaze.

A/B-1/13: Set Iron County Remonumentation monument, witnessed by:

12" Maple N25°E 40.13'

3" Maple S41°W 15.18'

23" Red Pine S31°E 97.74' (nail blaze only)


8" Balsam N23°W 4.84'

Sign Post N82°W 0.8'

Signed by *Alan K. Pierce*

Date 1-12-95

Surveyor's Michigan License No. 30097

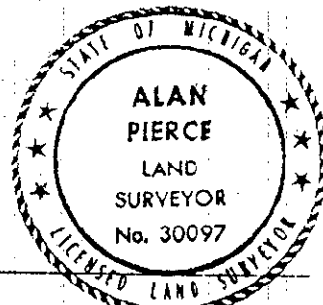

FORM APPROVED BY MICHIGAN STATE BOARD OF LAND SURVEYORS, JAN. 28, 1971
REVISED MAY 14, 1975
REVISED JAN., 1983

51074m03

LIBER

6 PAGE 348