

SURVEY &
REMONUMENTATION

JAN 19 1999

SECTION

LAND CORNER RECORDATION CERTIFICATE
Filing Requirement of Act 74, Mich. P.A. 1970

For corners in

Iron
(County)

Located in:

Corner Code #

1. Public Land Survey

T 43N R 35W

J-5

T R

T R

T R

2. Property Controlling
in Section

S T R

S T R

3. Miscellaneous

S T R

Property in Sec.

S T R

IRON COUNTY
MICHIGAN
RECEIVED FOR RECORD

98 DEC 28 AM 11:29

L.C. Records: L. 7, P. 335

Gary L. Pisoni

Register of Deeds Stamp & File Number

4. Lot No. , Recorded Plat

5. Private Claims

Quarter Corner Sections 11 and 14, T43N, R35W

I, Gary L. Pisoni, in a field survey on December 16, 1998 do hereby state that under requirements of P.A. 74, Michigan P.A. of 1970, the corner points mentioned in lines 1 and 2 above were in conformance with regulations and rules therefore as required in the current manual of survey instructions of the United States Department of the Interior, Bureau of Land Management or by a decree of a Court of Law and/or that the corner points mentioned in lines 3, 4 and 5 above were in conformance with the rules of the Michigan Board of Land Surveyors or by a Decree of a Court of Law; established, re-established, monumented, recovered, found as expressed below:

NOTE: Not more than 2 corners, all in the same town and range, may be recorded on this certificate.

	A	B	C	D	E	F	G	H	I	J	K	L	M
1													
2	6			5			4			3		2	1
3													
4	7			8			9			10		11	12
5													
6	18			17			16			15		14	13
7													
8	19			20			21			22		23	24
9													
10	30			29			28			27		26	25
11													
12	31			32			33			34		35	36
13													

A. Description of original monument and accessories and/or subsequent restoration:

Original corner established in August, 1851 by Harvey Mellen, Deputy Surveyor.

Original Corner; Wood Post

Original Bearing Trees:

Yellow Birch
Hemlock

24"
8"

S 45° W
N 42° E

1 lks (0.66 feet)
29 lks (19.14 feet)

PEER GROUP APPROVED

Iron *G. Pisoni* *12-18-98*
COUNTY REPRESENTATIVE

B. Description of corner evidence found and/or method applied in restoring or reestablishing corner:

No evidence of original B.T.s found.

Found a railroad spike near the centerline of an East/West county road, on line and midway between the Southwest and Southeast Section corners of Section 11. Railroad spike is located on a fence line running South and on the centerline of a farm road to the North.

Railroad spike is 3 feet South of the centerline of a county road.

I accept the railroad spike as the best available evidence for restoring the corner position.
Distance along the Section line is consistent with GLO distance.

Corner record research on file with County Representative.

C. Description of monument for corner and accessories established to perpetuate locating the position of the corner:
From the above described corner position, I set two reference monuments, being a 5/8" diameter by 30" long rebar, with a 3" aluminum cap stamped as follows: Iron County Remonumentation, T43N, R35W, R.M., 1/4, S-11, S-14, N 54° W, 46.76', 1998, RLS 27457; T43N, R35W, R.M., 1/4, S-11, S-14, North, 24.08', 1998, RLS 27457 from which the following reference objects bear:

Utility Pole #62

N 67°W

83.16 feet

Utility Pole

N 75°E

104.50 feet

R.M. 5/8" x 30" rebar

S 54°E

46.76 feet

R.M. 5/8" x 30" rebar

South

24.08 feet

Steel sign post

South

24.8 feet


98-163

Signed by *Gary L. Pisoni*

Date 12-21-98

Surveyor's Michigan License No. 27457

FORM APPROVED BY MICHIGAN STATE BOARD OF PROFESSIONAL SURVEYORS, JAN. 28, 1971
REVISED MAY 14, 1975
REVISED JAN., 1983
REVISED OCT., 1995

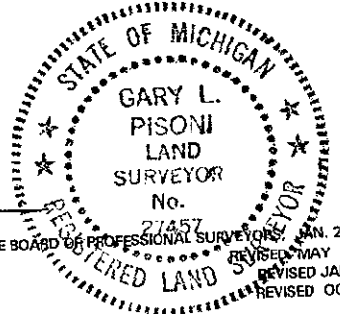

L. 7 P. 335