

LAND CORNER RECORDATION CERTIFICATE
Filing Requirement of Act 74, Mich. P.A. 1970 as Amended

For corners in

Iron (County)	Located In:	Corner Code #
1. Public Land Survey	T _____ R _____ T _____ R _____ T _____ R _____	_____ _____ _____
2. Property Controlling in Section	S 4 T 44N R 31W S 4 T 44N R 31W S _____ T _____ R _____	1 4 _____
3. Miscellaneous Property in Sec.	S _____ T _____ R _____ S _____ T _____ R _____	_____ _____
4. Lot No. _____, Recorded Plat _____		
5. Private Claims _____		

Register of Deeds Stamp & File Number

	A	B	C	D	E	F	G	H	I	J	K	L	M
1													
2	6		5			4		3		2		1	
3													
4	7		8			9		10		11		12	
5													
6	18		17			16		15		14		13	
7													
8	19		20			21		22		23		24	
9													
10	30		29			28		27		26		25	
11													
12	31		32			33		34		35		36	
13													

I, Stephan J. Szyszkoski, in a field survey on 4 09/21/2011 do hereby state
that under requirements of P.A. 74, Michigan P.A. of 1970, the corner points mentioned in lines 1 and 2
above were in conformance with regulations and rules therefore as required in the current manual of survey
instructions of the United States Department of the Interior, Bureau of Land Management or by a decree of
a Court of Law and /or that the corner points mentioned in lines 3, 4 and 5 above were in conformance with
the rules of the Michigan Board of Land Surveyors or by a Decree of a Court of Law; established,
re-established, monumented, recovered, found as expressed below:

NOTE: Not more than 2 corners, all in the same town and range, may be recorded
on this certificate.

A. Description of original monument and accessories and/or subsequent restoration:

(1-Sec. 4) West 1/16 corner between Section 4 T44N-R31W and Section 33 T45N-R31W. 1968 - Monumented
by A.O.Enger RLS by proportionate measurement between Section corner 60.052 chains east and Township
corner 179.501 chains west. Set 1"IDx36" I.pipe with 4" alum. cap. W.Spruce 9" S14W 20.5 links,
B.Spruce 6" N07W 23 links.

(4-Sec. 4) Northwest 1/16 corner, Section 4. Not previously monumented.

B. Description of corner evidence found and/or method applied in restoring or reestablishing corner:

(1-Sec. 4) Established the position for the corner midway and on the Township line between Section
corner 1321.58' west and Quarter corner 1321.58' east. The 1968 monument was recovered N37E 1.92'
distant, was not accepted, and was removed.

(4-Sec. 4) Established the position for the corner at the intersection of straight lines connecting
opposite 1/16 corners.

C. Description of monument for corner and accessories established to perpetuate locating the position of the corner:


(1) Set 1"IDx32" I.pipe with 4" alum. MDNR cap.
Set measuring nail with MDNR tag in the side of:
7" Maple N76E 18.95' mrkd "1/16S BT"
5" B.Spruce S45E 9.15' do
13" Spruce S10W 11.5' old blazes 1968 BT
7" B.Spruce N77W 19.6' mrkd "1/16S BT"
Set sq'd Cedar post adjacent.
Bearings are magnetic.

(4) Set 1"IDx32" I.pipe with 4" alum. MDNR cap.
Set measuring nail with MDNR tag in the side of:
2" Maple N36E 10.2' mrkd " X X "
6" W.Spruce S60E 21.5' "1/16S BT"
6" Sugar S11W 38.7' do
3" Maple S80W 7.9' do
Set sq'd Cedar post adjacent.
Bearings are magnetic.

Signed by Stephan J. Szyszkoski
Surveyor's Michigan License No. 33986

Date 01/19/2012

For the Michigan Department of Natural Resources, Forest Management Division

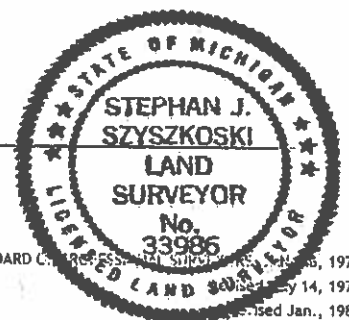

16797

16798