

LAND CORNER RECORDATION CERTIFICATE

Authority: 1970 PA 74, MCL 54.205

Surveyor's Name: Stephan J. Szyszkoski

Field Survey Date: See below

For corner(s) in: Iron County

Original Public Land Survey Corner


Corner Code

S T R
S T R
S T R
S T R

Property Corner

1/16 Corner Code

a. S 10 T 44N R 32W 14 (GCDB 500520)
a. S 11 T 44N R 32W 10 (GCDB 500520)
b. S 10 T 44N R 32W 16 (GCDB 460500)
b. S 15 T 44N R 32W 2 (GCDB 460500)

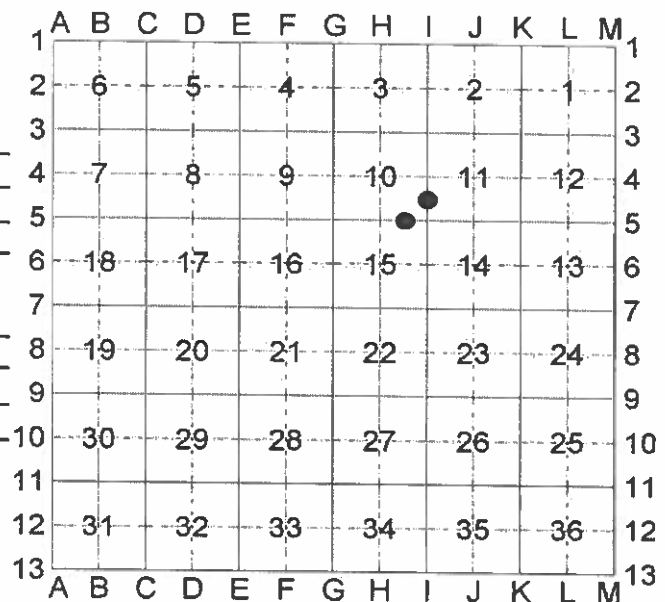

Part A. Corner History

a. South 1/16 corner between Sections 10 and 11 T44N-R32W. 1989 - Established by K.L.Sackett RLS midway and on line between corners north and south. Set 1"IDx32" I.pipe with 4" alum. MDNR cap. 7" Spruce S68°W 18.6'; 8" Balsam S30°W 14.8'; 6" Spruce S54°E 34.9'.

b. East 1/16 corner between Sections 10 and 15 T44N-R32W. 1989 - Established by K.L.Sackett RLS midway and on line between corners east and west. Set 1"IDx36" I.pipe with 4" alum. MDNR cap. 14" Spruce N23°W 28.2'; 16" Tamarack N78°E 36.2'; 8" Aspen S29°W 15.0'.

Part B: Surveyor's Report on Perpetuation, Restoration, Reestablishment, or Monumentation of Corner

a. May 8 2018. Found the 1989 monument in good condition and substantially at the record position. The 1989 witnesses are now all dead and down. Accepted the monument as a careful and faithful determination of the position of the corner.

b. May 8 2018. Found the 1989 monument in good condition and substantially at the record position. The 1989 witnesses are all dead and down. Accepted the monument as a careful and faithful determination of the position of the corner.

Part C: Field Evidence of Perpetuation or Monumentation of Corner

a. Found 1"ID I.pipe with 4" alum. MDNR cap.
Set measuring nail with MDNR tag in the side of:
5" Poplar N50°E 9.05' mrkd "1/16S BT"
4" B.Spruce S38°E 14.0' do
3" B.Spruce S49°W 11.5' do
5" Poplar N29°W 7.45' do
Set sq'd cedar post adjacent.
E= 7900946.38 N= 160641.98

b. Found 1"ID I.pipe with 4" alum. MDNR cap.
Set measuring nail with MDNR tag in the side of:
4" W.Spruce N81°E 4.4' mrkd "1/16S BT"
9" Poplar S39°W 12.65' do
7" W.Spruce S80°W 14.2' do
7" W.Spruce N20°W 9.25' do
Set sq'd cedar post adjacent.
E= 7900537.53 E= 160247.21

Bearings are magnetic. Coordinates are MCS83 in meters, NAD83(2011) Epoch 2010.00

Stephan J. Szyszkoski

05/30/2018

Professional Surveyor's License No.: 33986

page 1 of 1

Prepared By: S.J. Szyszkoski for the Michigan Dept. of Natural Resources, 427 N. US41 Baraga, MI 49908

