

SURVEY & REMONUMENTATION

FEB 21 2001

SECTION

COMMENCING YEAR 2000
RECEIVED FOR RECORD
IRON COUNTY, MICHIGAN

00 DEC -5 PM 12: 51

L.C. Records 11.8. P.232

Robert A. Goodreau
REGISTERED 1970S

LAND CORNER RECORDATION CERTIFICATE Filing Requirement of Act 74, Mich. P.A. 1970

For corners in


Iron _____ (County)	Located In:	Corner Code #
1. Public Land Survey	T 43N R 36W	M-1
	T 44N R 36W	M-13 ✓
	T 43N R 35W	A-1
	T 44N R 35W	A-13
2. Property Controlling in Section	S _____ T _____ R _____	_____
3. Miscellaneous Property in Sec.	S _____ T _____ R _____	_____

Register of Deeds Stamp & File Number

4. Lot No. _____, Recorded Plat _____
5. Private Claims _____

I, Robert A. Goodreau in a field survey on May 11, 2000 do hereby state that under requirements of P.A. 74, Michigan P.A. of 1970, the corner points mentioned in lines 1 and 2 above were in conformance with regulations and rules therefore as required in the current manual of survey instructions of the United States Department of the Interior, Bureau of Land Management or by a decree of a Court of Law and/or that the corner points mentioned in lines 3, 4 and 5 above were in conformance with the rules of the Michigan Board of Land Surveyors or by a Decree of a Court of Law: established, re-established, monumented, recovered, found as expressed below:

NOTE: Not more than 2 corners, all in the same town and range, may be recorded on this certificate.

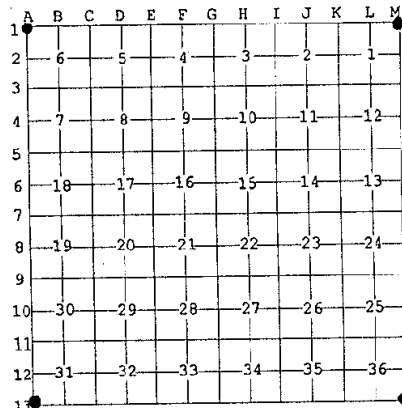

A. Description of original monument and accessories and/or subsequent restoration:

Original corner established by William A. Burt, U.S. Deputy Surveyor, in 1846.

Original witnesses: Spruce 12" S 21° E 32 links
Spruce 12" N 47° W 38 links

Donald D. Lappala RLS restored corner position on 21 April 1967 from recovered natural features East, West, and South. He set a 2" x 5' concrete filled galvanized iron pipe w/ bronze cap at the corner location (Liber 4, Page 51).

B. Description of corner evidence found and/or method applied in restoring or reestablishing corner:

Found monument as described by Lappala, 2 ft. North of fence.

Found witnesses recorded by Lappala as: 6" Spruce N 80° W 6.3' (9.5 links)
10" Spruce N 30° E 18.7' (28.3 links)
5" Spruce N 82° E 57.9' (87.7 links)

Corner record research on file with county representative.

PEER GROUP APPROVED

Don Davidson 11-14-00
COUNTY REPRESENTATIVE

C. Description of monument for corner and accessories established to perpetuate locating the position of the corner:

Accepted corner as found.

Witnesses: 10" Spruce N 74° W 6.85' (USFS BT sign)
12" Spruce N 36° E 18.62' (USFS BT sign)
7" Spruce N 86° E 57.36' (USFS BT sign)
Fence post S 71° E 9.40'
Sign post North 3.6'

Note: Measurements taken to a nail in side of witnesses.

Signed by *Robert A. Goodreau*
Surveyor's Michigan License No. 43053

Date July 1, 2000