

SURVEY & REMONUMENTATION

FORM NO. 965-A



Stock No. 26273

MAR 19 1997

COMMISSION

LAND CORNER RECORDATION CERTIFICATE Filing Requirement of Act 74, Mich. P.A. 1970

For corners in

Iron
(County)

Located In:

Corner Code #

1. Public Land Survey

T 46N R 34W D.E-13A (002)

T 45N R 34W D.E-1A (003)

T R

T R

2. Property Controlling
in Section

S T R

S T R

3. Miscellaneous
Property in Sec.

S T R

S T R

4. Lot No. , Recorded Plat

5. Private Claims

West Witness Corner

Meander Corner between S.32, T46N R34W
S.5, T45N R34W

I, Gary L. Pisoni, in a field survey on October 22, 19 96 do hereby state that under requirements of P.A. 74, Michigan P.A. of 1970, the corner points mentioned in lines 1 and 2 above were in conformance with regulations and rules therefore as required in the current manual of survey instructions of the United States Department of the Interior, Bureau of Land Management or by a decree of a Court of Law and/or that the corner points mentioned in lines 3, 4 and 5 above were in conformance with the rules of the Michigan Board of Land Surveyors or by a Decree of a Court of Law; established, re-established, monumented, recovered, found as expressed below:

NOTE: Not more than 2 corners, all in the same town and range, may be recorded on this certificate.

A. Description of original monument and accessories and/or subsequent restoration:

Original corner established by William A. Burt, U.S. Deputy Surveyor on September 18, 1846.

Original corner: Fir Post

Original bearing trees:

Hemlock	18"	N 19° W	34 Links (22.44 feet)
Hemlock	22"	S 25° W	36 Links (23.76 feet)

B. Description of corner evidence found and/or method applied in restoring or reestablishing corner:

No original corner evidence found.

Set Witness Corner Meander Corner on West shore of Porter Lake on line between the North Quarter corner and the Northeast Section corner of Section 5, T45N R34W.

Corner Record Research on file with County Representative.

C. Description of monument for corner and accessories established to perpetuate locating the position of the corner:

At the corner position, I set a 3/4" outside diameter by 3 feet long aluminum rod monument with a 3" cast aluminum cap, stamped to read: Iron County Remonumentation, T46N, R34W, S-32, S-5, W.C., M.C., T45N, 1996, RLS-27457 from which I established the following new blazed and scribed bearing trees: (all measurements taken to a nail in side of tree)

Cedar	10"	S 37° E	13.36 feet
Sugar Maple	8"	S 17° W	73.03 feet
Sugar Maple	10"	N 83° W	55.10 feet
Cedar	11"	N 48° W	44.80 feet
Steel Sign Post	6'	N 80° E	1.40 feet

IRON COUNTY
MICHIGAN
RECEIVED FOR RECORD

96 DEC 23 AM 9:02

L.C. Records L. 7, P. 42


Gary L. Pisoni
COUNTY REPRESENTATIVE

Register of Deeds Stamp & File Number

	A	B	C	D	E	F	G	H	I	J	K	L	M
1													
2		6		5		4		3		2		1	
3													
4		7		8		9		10		11		12	
5													
6		18		17		16		15		14		13	
7													
8		19		20		21		22		23		24	
9													
10		30		29		28		27		26		25	
11													
12		31		32		33		34		35		36	
13													

PEER GROUP APPROVED

Gary L. Pisoni 12-11-96
COUNTY REPRESENTATIVE

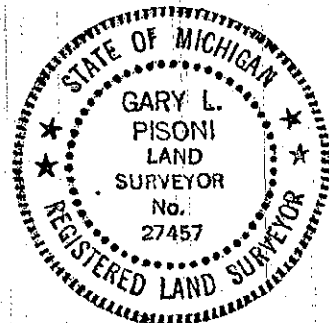

#96-20

Signed by *Gary L. Pisoni*

Date 12-10-96

Surveyor's Michigan License No. 27457

FORM APPROVED BY: MICHIGAN STATE BOARD OF PROFESSIONAL SURVEYORS, JAN. 28, 1971
REVISED MAY 14, 1975
REVISED JAN., 1983
REVISED OCT., 1995

L. 7 P. 42