

SURVEY & REMONUMENTATION

FEB 21 2001

SECTION

LAND CORNER RECORDATION CERTIFICATE

Filling Requirement of Act 74, Mich. P.A. 1970

For corners in

IRON

(county)

Located In:

Corner Code#

BATES TOWNSHIP

T 46 N, R 35 W

D-9 (S 1/4 SEC. 20)

1. Public Land Survey

2. Property controlling
in Section

3. Miscellaneous
Property in Sec.

S

S

S

S

4. Lot No. _____, Recorded Plat _____

5. Private Claims _____

1/4 CORNER COMMON TO SECTIONS 20 AND 29, T 46 N, R 35 W

I, STEVEN R. APPLEKAMP in a field survey on NOVEMBER 9, 2000 do hereby state that under requirements of P.A. 74, Michigan P.A. of 1970, the corner points mentioned in lines 1 and 2 above were in conformance with regulations and rules therefore as required in the current manual of survey instructions of the United States Department of the Interior, Bureau of Land Management of by decree of a Court of law and/or that the corner points mentioned in lines 3, 4 and 5 above were in conformance with the rules of the Michigan Board of Land Surveyors or by Decree of a Court of Law; established, re-established, monumented, recovered, found as expressed below:

NOTE: Not more than 2 corners, all in the same town and range, may be recorded on this certificate.

A. Description of original monument and accessories and/or subsequent restoration:

ORIGINAL CORNER ESTABLISHED BY HARVEY MELLEN, U.S. DEPUTY SURVEYOR ON JUNE 12, 1851.

ORIGINAL BEARING TREES:

HEMLOCK	HEMLOCK
18"	24"
S 45°E	N 63°W
14 LINKS	19 LINKS

B. Description of corner evidence found and/or method applied in restoring or reestablishing corner:

FOUND NO ORIGINAL EVIDENCE, PLACED CORNER AT A SINGLE PROPORTINATE LOCATION FROM ALREADY ESTABLISHED CORNERS ONE-HALF MILE EAST AND ONE-HALF MILE WEST.

C. Description of monument for corner and accessories established to perpetuate locating the position of the corner:

SET A 3 FOOT LONG 3/4" ALUM. ROD WITH A 3" CAST ALUM CAP STAMPED TO DESIGNATE THE CORNER LOCATION. WE MADE THE FOLLOWING REFERENCES: (ALL MEASUREMENTS TAKEN TO NAIL IN SIDE OF TREE)

BALSAM	MAPLE	SPRUCE	MAPLE	STEEL SIGN
6"	10"	8"	9"	POST
N 75°E	S 44°E	S 32°W	N 84°W	NE
22.36'	5.52'	27.26'	35.82'	0.70'



COMMENCING YEAR 2000
RECEIVED FOR RECORD
IRON COUNTY, MICHIGAN

00 DEC -4 AM 10:08

L.C. Record: L.S. P. 184

Steven R. Applekamp
REGISTERED PROFESSIONAL SURVEYOR

Register of Deeds Stamp & File Number

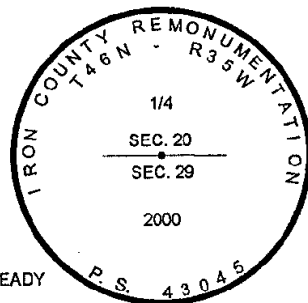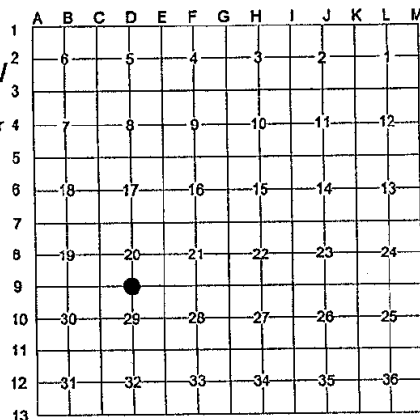

PEER GROUP APPROVED

Iron County Peer Group 11-30-2000
COUNTY REPRESENTATIVE



Signed by

Steven R. Applekamp

Date

NOVEMBER 9, 2000

Surveyor's Michigan License No.

43045

LIBER

8

PAGE

184