

SURVEY & REMONUMENTATION

FEB 21 2001

SECTION

LAND CORNER RECORDATION CERTIFICATE Filling Requirement of Act 74, Mich. P.A. 1970

For corners in

IRON

(county)

BATES TOWNSHIP

Located in:

Corner Code#

T 46 N, R 35 W

F-9 (N1/4 SEC.28)

1. Public Land Survey

2. Property controlling
in Section

S

S

3. Miscellaneous

S

Property in Sec.

S

4. Lot No. _____, Recorded Plat _____

5. Private Claims _____

1/4 CORNER COMMON TO SECTIONS 21 AND 28 T 46 N, R 35 W

I, STEVEN R. APPLEKAMP in a field survey on NOVEMBER 9, 2000 do hereby state that under requirements of P.A. 74, Michigan P.A. of 1970, the corner points mentioned in lines 1 and 2 above were in conformance with regulations and rules therefore as required in the current manual of survey instructions of the United States Department of the Interior, Bureau of Land Management or by decree of a Court of law and/or that the corner points mentioned in lines 3, 4 and 5 above were in conformance with the rules of the Michigan Board of Land Surveyors or by Decree of a Court of Law; established, re-established, monumented, recovered, found as expressed below:

NOTE: Not more than 2 corners, all in the same town and range, may be recorded on this certificate.

A. Description of original monument and accessories and/or subsequent restoration:

ORIGINAL CORNER ESTABLISHED BY HARVEY MELLEN, U.S. DEPUTY SURVEYOR ON JUNE 12, 1851.

ORIGINAL BEARING TREES:	HEMLOCK 12"	Y-BIRCH 6"
	N 34°E	S 22°W
	20 LINKS	13 LINKS

1968 DONALD D. LAPPALA P.S. 12585 RESTORED CORNER FROM FOUND EVIDENCE WHICH INCLUDED THE ORIGINAL BEARING TREES. HE SET A 2" I.D. BY 4 FEET LONG GALVANIZED IRON PIPE WITH 3" BRONZE TABLET STAMPED AS FOLLOWS: T.46N., R.35W.; S-21, S-28; R.L.S. 12585; 1967, RECORDED IN IRON COUNTY L.C. RECORDS HE MADE THE FOLLOWING BEARING TREES:

SUGAR 9"	SUGAR 6"	SUGAR 10"
N 03°E	S 60°E	S 21°W
6.3'	17.1'	23.4'

B. Description of corner evidence found and/or method applied in restoring or reestablishing corner:

FOUND CORNER IN GOOD CONDITION AS RECORDED IN 1968 AS PER LAND CORNER RECORD, ACCEPTED CORNER POSITION AS IT MATCHED THE BEARING TREES FOUND.

EXISTING SUGAR 15"	EXISTING SUGAR 8"	EXISTING SUGAR 15"
N 05°E	S 56°E	S 25°W
6.49'	16.84'	23.36'

C. Description of monument for corner and accessories established to perpetuate locating the position of the corner:

THE CORNER IS A 3" BRONZE TABLET ON A 2" GALV. PIPE APPROX. 1.5 ABOVE THE GROUND STAMPED AND IN THE ORIGINAL POSITION PER THE 1968 LAND CORNER RECORDATION CERTIFICATE. WE MADE THE FOLLOWING ADDITIONAL REFERENCES: (ALL MEASUREMENTS TAKEN TO NAIL IN SIDE OF TREE)

SUGAR 7"	STEEL SIGN POST
N 78°W	NE
58.92'	0.65'



Signed by

Steven R. Applekamp

Surveyor's Michigan License No.

43045

Date

NOVEMBER 9, 2000


COMMENCING YEAR 2000
RECEIVED FOR RECORD
IRON COUNTY, MICHIGAN

00 DEC -4 AM 10: 09

L.C. Records: L. 8, P. 190

William J. Miller
Register of Deeds

Register of Deeds Stamp & File Number

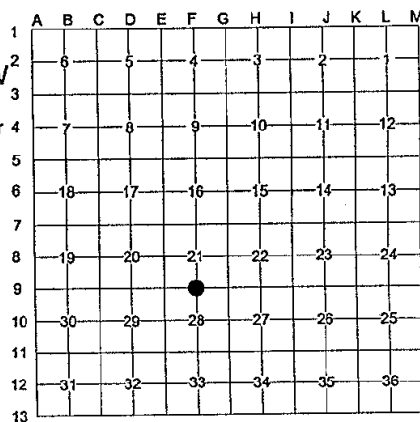

PEER GROUP APPROVED

Iron County Surveyors 11-30-2000
COUNTY REPRESENTATIVE