

11039

LAND CORNER RECORDATION CERTIFICATE
Filing Requirement of Act 74, Mich. P.A. 1970
Isabella County Remonumentation

JAN 19 2001

SECTION

For Corners in
Isabella

(County)

Located In:

Corner Code#:

1. Public Land Survey T. 13N R. 4W M-6
T. R.
T. R.
2. Public Controlling S. T. R.
in Section S. T. R.
3. Miscellaneous S. T. R.
Property in Section S. T. R.
4. Lot No. , Recorded Plat
5. Private Claims

200000011039
Filed for Record in
ISABELLA COUNTY, MI
SHARON A BROWN
On 12-19-2000 At 09:09:12 am.
RE LAND COR 9.00
Liber 2 Page 11 - 11
//

Register of Deeds Stamp & File Number

I, Jan S. Fokens, in a field survey on June 19, 2000, do hereby certify that under requirements of P.A. 74, Michigan P.A. of 1970, the corner points mentioned in lines 1 and 2 above were in conformance with regulations and rules therefore as required in the current manual of survey instructions of the United States Department of the Interior, Bureau of Land Management or by a decree of a Court of Law and/or that the corner points mentioned in lines 3, 4 and 5 above were in conformance with the rules of the Michigan Board of Land Surveyors or by a Decree of a Court of Law, established, re-established, monumented, re-monumented, recovered, found as expressed below.

NOTE: Not more than 2 corners, all in the same town and range, may be recorded on this certificate.

A. Description of original monument and accessories and/or subsequent restoration:

1. G.L.O Original Survey:
Township: Robert Clark Jr. 2nd Quarter 1831
Pages 148, 150, original field notes
2. County Survey Records:
Liber 2, Page 211 Joseph Graham December 1883 Found stone set by A.K. Herrington
3. L.C.R.C.:
Liber 1, Page 530 Jerry Jones Recorded date July 16, 1979 Found pipe and plug
4. Surveys of Record:
Liber 003, Page 270 Hunter & Whittier 1979 Found pipe and plug
Liber 005, Page 362 & 364 Mid-Michigan Engineering 1993 Found 5/8" capped iron
5. Unrecorded Survey:
None available

B. Description of corner evidence found and/or method applied in restoring or re-establishing corner:

This corner established in Isabella County Remonumentation Program. See dossier for detailed report.
This is a lost corner

Set corner half way and on line between the NE and SE corners of section 13, T.13N.-R.4W., Lincoln Township, Isabella Co., MI.

Note: Noted LCRC's and surveys of record used A-6 as M-6

Accepted as the best available evidence of the position of the original corner and replaced with Standard Monument Corner.


C. Description of monument for corner and accessories established to perpetuate locating the position of the corner:

Set Standard Isabella County Monument in Monument Box, stamped M-6 and PS 21567.

M-6 E. 1/4 Corner, Section 13, Lincoln Township, T.13N.-R.4W., Isabella Co., MI.

N.75°W.	30.63'	Top center of GTE cable riser
S.45°W.	30.59'	Chiseled "+" in top center of S. end of cmp
North	6.69'	A-6, W. 1/4 Corner, Section 18, T.13N.-R3W., Coe Township, Isabella County, MI.
S.85°E.	88.82'	Set LSC nail and tag in S. face of Crab Apple clump
N.00°51'15"E.	2636.66'	(M-5) NE. Corner, Section 13, T.13N.-R.4W., Lincoln Township, Isabella County, MI.
S.00°51'15"W.	2636.66'	(M-7/A-7) Common SW/SE Corner, Sections 13/18, Lincoln/Coe Townships, Isabella Co., MI.

	A	B	C	D	E	F	G	H	I	J	K	L	M
2	6	5	4	3	2	1							
3													
4	7	8	9	10	11	12							
5													
6	18	17	16	15	14	13							
7													
8	19	20	21	22	23	24							
9													
10	30	29	28	27	26	25							
11													
12	31	32	33	34	35	36							
13													

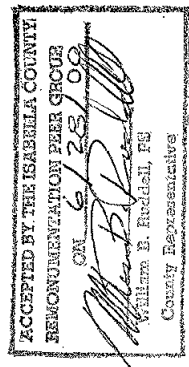

Signed by Jan S. Fokens
Surveyor's Michigan License No. 21567

Date 12/12/00