

SURVEY &
REMONUMENTATION

APR 29 1996

COMMISSION

REMONUMENTATION CORNER
LAND CORNER RECORDATION CERTIFICATE
Filing Requirement of Act 74, Mich. P.A. 1970

For Corners in
Isabella
(County)

Located In: Corner Code #

- | | | | | | |
|------------------------------------|---|------------|---|-----------|------------|
| 1. Public Land Survey | T | <u>13N</u> | R | <u>6W</u> | <u>K-4</u> |
| | T | | R | | |
| | T | | R | | |
| | T | | R | | |
| | T | | R | | |
| 2. Property Controlling in Section | S | | T | R | |
| | S | | T | R | |
| 3. Miscellaneous | S | | T | R | |
| Property in Sec. | S | | T | R | |

STATE OF MICHIGAN
COUNTY OF ISABELLA
RECEIVED FOR RECORD

FEB 23 22 PM '96

000094
SHARON A. BROWN
REGISTER OF DEEDS

Register of Deeds Stamp & File Number

4. Lot No. _____, Recorded Plat _____
5. Private Claims _____

I, Gerald J. Gray, in a field survey on March 21, 1995, do hereby certify that under requirements of P.A. 74, Michigan P.A. of 1970, the corner points mentioned in lines 1 and 2 above were in conformance with regulations and rules therefore as required in the current manual of survey instructions of the United States Department of the Interior, Bureau of Land Management or by a decree of a Court of Law and/or that the corner points mentioned in lines 3, 4, and 5 above were in conformance with the rules of the Michigan Board of Land Surveyors or by a Decree of a Court of Law; established, re-established, monumented, re-monumented, recovered, found as expressed below:

Note: Not more than 4 corners, all in the same town and range, may be recorded on this certificate.

A. Description of original monument and accessories and/or subsequent restoration:

1. Original G.L.O. Survey:
John Milroy D.S., Nov. 17, 1837 - Dec. 4, 1837, north between section 11 & 12, set quarter section post
2. E. R. Coburn, Moore, Roberts, Chapman, 1887, set stone 4x6x10 for 1/4 post (error the stake is 12 links north, an error of the chainman in 87-erc-nov-22-88)
3. E. R. Coburn, Nov. 22, 1888, corner stone 4x6x10
4. L.C.R.C.
Gerald J. Gray, 3/91
5. Unrecorded Survey by Gerald J. Gray, 4/15/91


Found iron below pavement
Found 1" pipe 2' below pavement, 4/15/91

B. Description of corner evidence found and/or method applied in restoring or reestablishing corner:

Found 1" pipe 2' below pavement, Set standard Isabella County Monument in monument box

C. Description of monument for corner and accessories established to perpetuate locating the position of the corner:

Standard Isabella County Monument in Monument Box
221° AZ 79.44' 4" Red Pine
309° AZ 110.10' SE House foundation corner
72° AZ 22.95' Corner fence post
95° AZ 37.22' 4" Boxelder in cluster
296° AZ 7' 3/4" Pipe

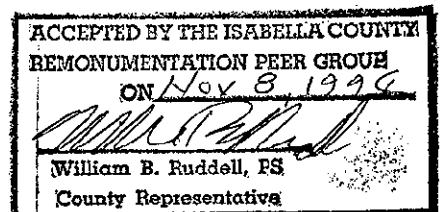

Signed by

Date 1-24-96

Surveyor's Michigan License No. 17741

