

MAR 09 1998

LAND CORNER RECORDATION CERTIFICATE  
Filing Requirement of Act 74, Mich. P.A. 1970  
Isabella County Remonumentation

SECTION

9700125682

Filed for Record in  
ISABELLA COUNTY, MI

SHARON A BROWN

On 11-10-1997 At 01:12:16 pm.

RE LAND COR 9.00

Book OR Vol. 1 Pg. 205 - 205

For Corners in

Isabella

(County)

Located In:

Corner Code#:

1. Public Land Survey T. 14N R. 4W K-6  
T. R.  
T. R.  
2. Public Controlling S. T. R.  
in Section S. T. R.  
3. Miscellaneous S. T. R.  
Property in Section S. T. R.  
4. Lot No. Recorded Plat  
5. Private Claims

Register of Deeds Stamp &amp; File Number



I, Jan S. Fokens, in a field survey on December 30, 1994, do hereby certify that under requirements of P.A. 74, Michigan P.A. of 1970, the corner points mentioned in lines 1 and 2 above were in conformance with regulations and rules therefore as required in the current manual of survey instructions of the United States Department of the Interior, Bureau of Land Management or by a decree of a Court of Law and/or that the corner points mentioned in lines 3, 4 and 5 above were in conformance with the rules of the Michigan Board of Land Surveyors or by a Decree of a Court of Law, established, re-established, monumented, re-monumented, recovered, found as expressed below.

**NOTE: Not more than 2 corners, all in the same town and range, may be recorded on this certificate.**

## A. Description of original monument and accessories and/or subsequent restoration:

1. G.L.O Original Survey  
Township Lines: N. S. & E. W. 2nd quarter 1837 by John Hodgson  
Subdivision and Resurvey: 4th Quarter 1838 R. Whitcomb  
Page 250 Original Field Notes
2. County Survey Records:  
No subsequent survey of record by County Surveyor
3. L.C.R.C.  
Liber 1, Pg. 235, William B. Ruddell 6/10/74 Found 1" pipe  
Liber 1, Pg. 441, P. Lapham 11/10/77 Found 3/4" pipe
4. Surveys of Record  
Liber 1, Pg. 531  
Liber 1, Pg. 579  
Liber 2, Pg. 224  
Liber 4, Pg. 56  
Liber 4, Pg. 243  
Liber 4, Pg. 247  
Liber 5, Pg. 283  
Liber 5, Pg. 285  
Liber 5, Pgs. 330-332

	A	B	C	D	E	F	G	H	I	J	K	L	M
1													
2	6	5	4	3	2	1							
3													
4	7	8	9	10	11	12							
5													
6	18	17	16	15	14	13							
7													
8	19	20	21	22	23	24							
9													
10	30	29	28	27	26	25							
11													
12	31	32	33	34	35	36							
13													

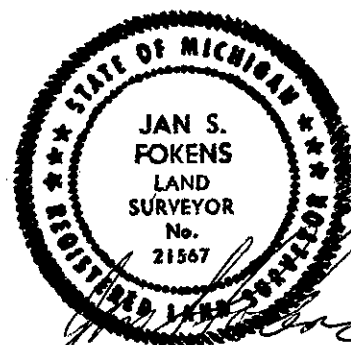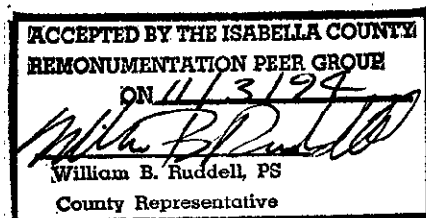

## B. Description of corner evidence found and/or method applied in restoring or re-establishing corner:

This corner established in Isabella County Remonumentation Program. See dossier for detailed report.

1. Found "pk" nail in asphalt
2. Verified position of "pk" nail from witness information on previous surveys and L.C.R.C. of record
3. Held position of found "pk" nail, and established new witness points outside of proposed construction limits for new construction of road intersection.

Accepted as the best available evidence of the position of the original corner and replaced with Standard Monument Corner. K-6 was approved for remonumentation at a Peer Review Committee meeting November 3, 1994.

## C. Description of monument for corner and accessories established to perpetuate locating the position of the corner:

Set Standard Isabella County Monument in Monument Box.  
N.17°W 137.33' nail & LSC tag in East face of 15" Elm  
N63°W 117.50' nail & LSC tag in South face of twin 12" & 15" Maple  
S67°W 143.34' NE corner of garage house #4976  
S58°E 148.85' Northwest corner of Jon's Corner Market Building

Signed by Jan S. Fokens  
Surveyor's Michigan License No. 21567

Date Nov 7, 1997