

# SURVEY & REMONUMENTATION

MAR 09 1998

## REMONUMENTATION CORNER

## SECTION

### LAND CORNER RECORDATION CERTIFICATE

Filing Requirement of Act 74, Mich. P.A. 1970 for Record in

9700125611  
ISABELLA COUNTY, MI  
SHARON A BROWN  
On 11-07-1997 At 08:56:00 am.  
RE LAND COR 9.00  
Book OR Vol. 1 Pg. 186 - 186

For corners in

Isabella  
(County)

Located in:

Corner Code #

1. Public Land Survey

T 14N R 6W

A-7

2. Property Controlling in Section

S T R

3. Miscellaneous Property in Sec.

S T R

4. Lot No. Recorded Plat

5. Private Claims

Register of Deeds Stamp & File Number


I, Ronald R. Harris, in a field survey on March 26, 19 97, do hereby certify that under requirements of P.A. 74, Michigan P.A. of 1970, the corner points mentioned in lines 1 and 2 above were in conformance with regulations and rules therefore as required in the current manual of survey instructions of the United States Department of the Interior, Bureau of Land Management or by a decree of a Court of Law and/or that the corner points mentioned in lines 3, 4 and 5 above were in conformance with the rules of the Michigan Board of Land Surveyors or by a Decree of a Court of Law; established, re-established, monumented, re-monumented, recovered, found as expressed below:

NOTE: Not more than 2 corners, all in the same town and range, may be recorded on this certificate.

A. Description of original monument and accessories and/or subsequent restoration:

- 1837 Post by John Hodson in Survey of Sec 24, T14N-R7W
- 1904 Coburn Fnd. stone by Mecosta co. Surveyor (B.4, P.20)
- 1968-72 MSHD Job No. 00519A Fnd. 3/4" pipe, raised with 5/8" iron rod
- 1975 Stevenson P.A.132 (L.002 P.46) Fnd 1" iron in Mon. Box
- 1975 Stevenson LCRC 340 Fnd 5/8" iron in Mon. Box
- 1993 Ruddell P.A.132 (L.005 P.293) Fnd. 5/8" rod in Mon. Box
- 1993 Ruddell LCRC 1234 Fnd 5/8" rod in Mon. Box
- 1994 Gray LCRC 1264 Fnd 3/4" iron in Mon. Box

	A	B	C	D	E	F	G	H	I	J	K	L	M
1													
2	6		5		4		3		2		1		
3													
4	7		8		9		10		11		12		
5													
6	18		17		16		15		14		13		
7													
8	19		20		21		22		23		24		
9													
10	30		29		28		27		26		25		
11													
12	31		32		33		34		35		36		
13													

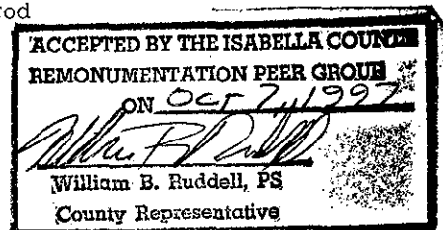

B. Description of corner evidence found and/or method applied in restoring or reestablishing corner:

March 1997 Found 1" iron rod, 25-1/2" long, in Mon. Box  
Excavated to depth of 3.7 feet, hit stones of undetermined size in water  
Found no further evidence or monumentation  
Measurements:  
A-7 to A-8 = 2637.59' (2637.53' MSHD)  
A-7 to B-7 = 2557.89' (2557.64' MSHD)


Accepted as the best available evidence for the position of the accepted corner. Corner was approved by the Peer Review Committee on:

C. Description of monument for corner and accessories established to perpetuate locating the position of the corner:

A standard remonumentation corner was set/stamped with corner's code number (A-7) and P.S. 41917.

#### WITNESSES:

West 27.55' Road sign Post (LCRC 1234)  
South 25.4' Centerline M-20  
WSW 210.85' Nail and cap Sign (LCRC 1234)  
SSW 150.09' Nail and cap in P.P. (LCRC 1234)  
ENE 64.35' Centerline of Storm manhole (LCRC 1264)

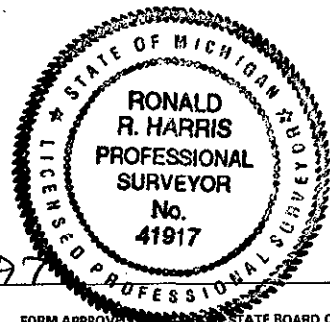

Signed by R. R. Harris

Date 10/30/97

Surveyor's Michigan License No. 41917

FORM APPROVED BY THE STATE BOARD OF LAND SURVEYORS.